


THE WEDGE, KINGS COVE BOULEVARD, METUNG

SEWERMAIN & WATERMAIN CONSTRUCTION

DRG. No. DESCRIPTION

2444/2000 LOCALITY PLAN AND DRAWING LIST
 2444/2001 OVERALL LAYOUT PLAN
 2444/2002 DETAIL LAYOUT PLAN - SHEET 1 OF 3
 2444/2003 DETAIL LAYOUT PLAN - SHEET 2 OF 3
 2444/2004 DETAIL LAYOUT PLAN - SHEET 3 OF 3

2444/5001 WATERMAIN OVERALL LAYOUT PLAN
 2444/5002 WATERMAIN DETAIL LAYOUT PLAN - SHEET 1 OF 3
 2444/5003 WATERMAIN DETAIL LAYOUT PLAN - SHEET 2 OF 3
 2444/5004 WATERMAIN DETAIL LAYOUT PLAN - SHEET 3 OF 3

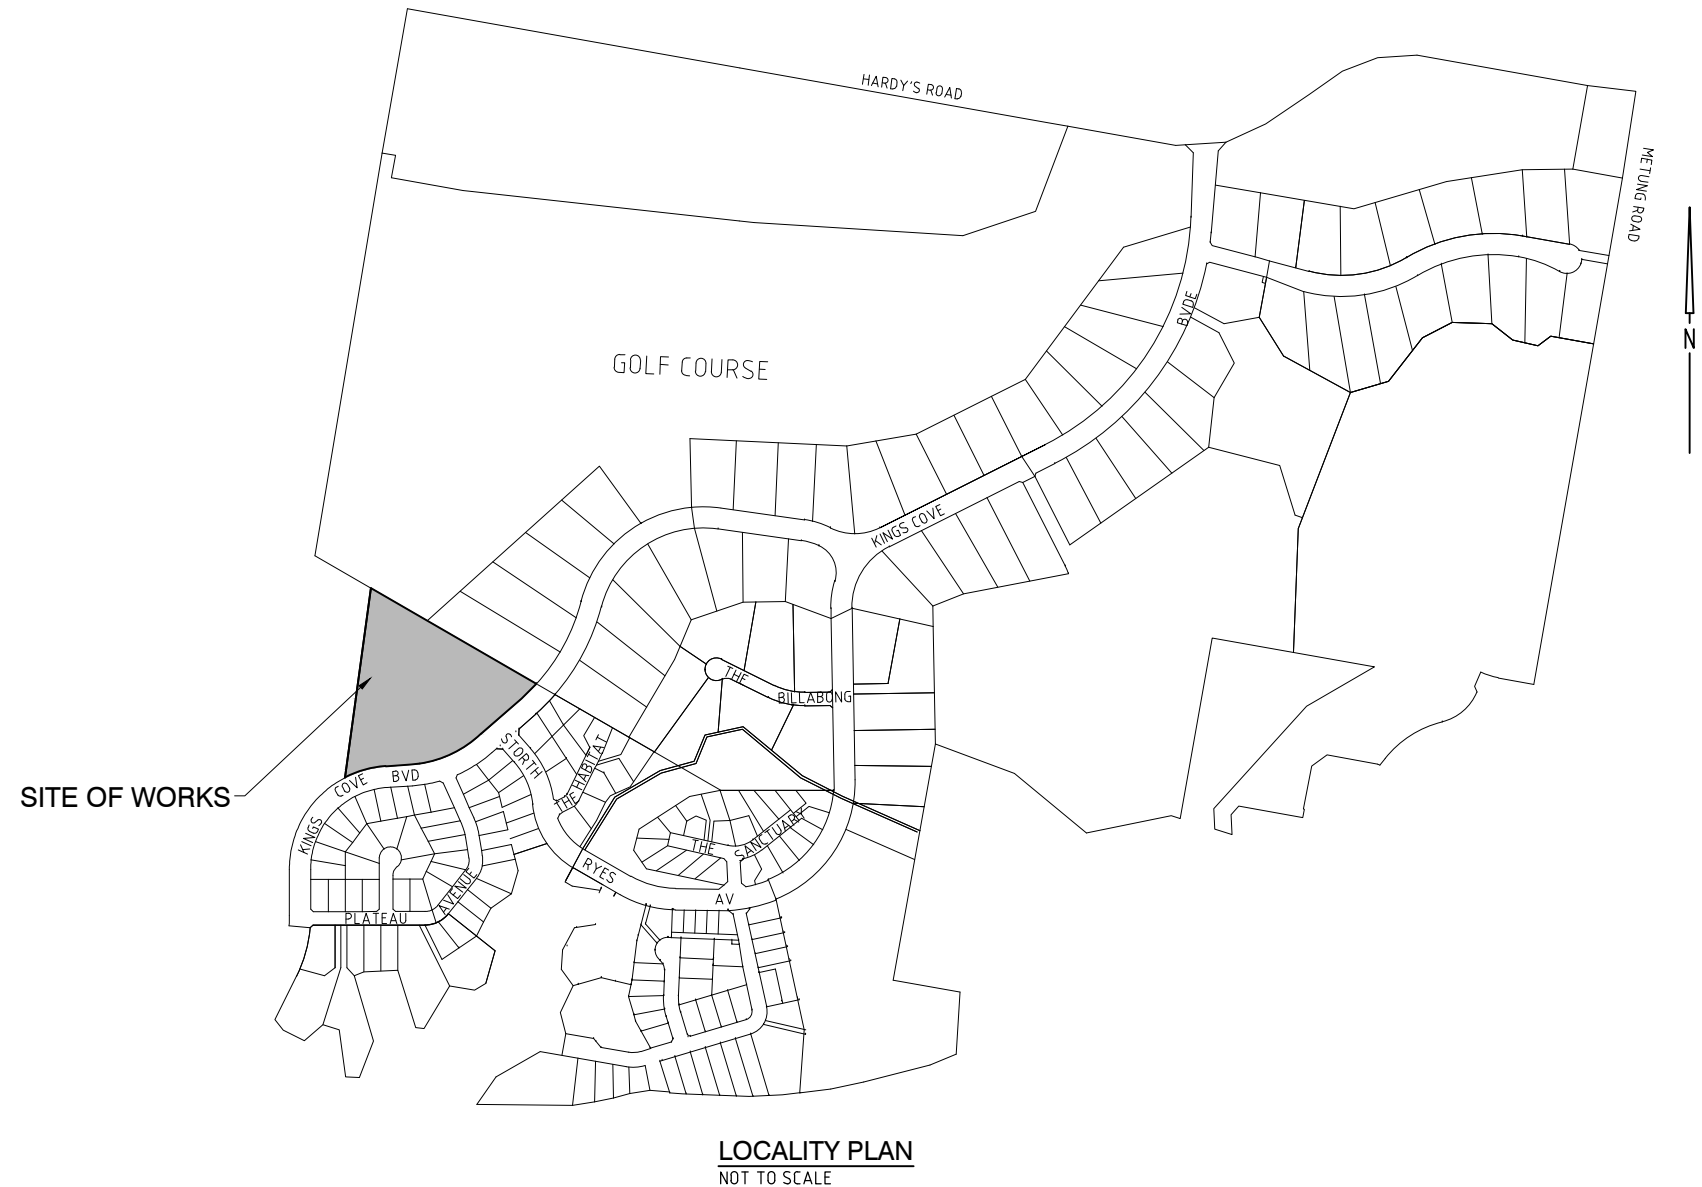

Rv	APPR	DATE	REVISIONS
G	M.S.	15-03-2024	ISSUED TO CLIENT/AGENT
F	M.S.	19-06-2023	AS CONSTRUCTED INFORMATION ADDED
E	A.G.	05-04-2023	ISSUED FOR CONSTRUCTION - UPDATED SEWER ALIGNMENT
D	A.G.	05-12-2022	ISSUED FOR CONSTRUCTION
C	A.G.	22-06-2022	EAST GIPPSLAND WATER AMENDMENTS
B	A.G.	18-05-2022	EAST GIPPSLAND WATER AMENDMENTS
A	A.G.	6-01-2021	ORIGINAL ISSUE

© Crossco Consulting Pty Ltd All Rights Reserved 2022.
 Copyright in the whole and every part of this drawing belongs to Crossco Consulting Pty Ltd and may not be used, sold, transferred, copied or reproduced in whole or in part in any manner or form or on any media, to any person other than by agreement with Crossco Consulting Pty Ltd.

This document is produced by Crossco Consulting Pty Ltd solely for the benefit of and use by the client in accordance with the terms of the retainer. Crossco Consulting Pty Ltd does not and shall not assume any responsibility or liability whatsoever to any third party arising out of any use or reliance by third party on the content of this document.

Crossco Consulting Pty Ltd
 ABN: 88 135 548 110
 154 Macleod St
 P.O. Box 858
 Bairnsdale Vic 3875
 Tel: (03) 51526298
 Fax: (03) 51527222
 Email: consult@crossco.com.au



DESIGNED: A.G.	A1	DATUM: A.H.D.
DRAWN: A.C.		
CHECKED: A.G.		
APPROVED: A.G.	SURVEY REF: 20210601	
SCALE: NOT TO SCALE	PLAN No: PS 845531 E	
XREF ATTACHED: R:\2444 Quaystone 120 KCB Metung\ACAD\Xref\2444_BP.dwg		
CAD FILE NAME: R:\2444 Quaystone 120 KCB Metung\ACAD\Org\2444-2000.dwg		

METUNG DEVELOPMENTS PTY LTD.	
EAST GIPPSLAND WATER	
THE WEDGE, KINGS COVE BOULEVARD, METUNG	
DATE: MARCH 2022	G
SHEET 1 OF 17	
DRAWING No:	
LOCALITY PLAN AND DRAWING LIST	2444/2000

WARNING:
BEWARE OF UNDERGROUND SERVICES
THE LOCATION OF UNDERGROUND SERVICES
ARE APPROXIMATE ONLY AND THEIR EXACT
POSITION SHOULD BE PROVEN ON SITE.
NO GUARANTEE IS GIVEN THAT ALL EXISTING
SERVICES ARE SHOWN.

WARNING:
BEWARE OF LIVE ELECTRICITY.

REFER TO DRAWING
No. 2444/2003 117

REFER TO DRAWING
No. 2444/2002









REFER TO DRAWING
No. 2444/2004



SURVEYED MANHOLE DETAILS

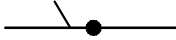STRUCTURE No.	COVER LEVEL RL. (m)	DEPTH (m)
EX 1-1	22.20	2.15
MH 1-2	22.26	1.98
MH 1-3	24.15	3.47
MH 1-4	25.06	3.94
MS 1-5	25.16	2.65
MS 1-6	26.15	3.45
MH 1-7	26.77	3.02
MS 1-8	28.61	1.65
MS 2-1	25.25	2.08
MS 3-1	26.39	2.51
EX 3-2	25.71	1.45
EX 4-1	26.78	1.35
MS 4-2	27.13	1.36
MH 5-1	24.16	2.25
MS 5-2	25.18	2.54
MH 5-3	26.43	1.91
MS 5-4	27.17	2.06
MS 6-1	24.10	1.94
MS 7-1	22.11	1.43
MH 8-1	26.60	1.44
MS 8-2	27.42	1.45
EX 8-3	27.50	1.50

FIRTHS PLUMBING AND CIVIL PTY LTD
(CONTRACTOR)
HAVE UNDERTAKEN THESE WORKS

LEGEND:


-  CONSTRUCTED SEWER WITH MH AND HC.
-  SEWER MANHOLE No. AND DISTANCE TO DOWNSTREAM MANHOLE
-  PROPERTY CONNECTION DISTANCE FROM DOWNSTREAM MANHOLE
-  ESTIMATED PIPE DEPTH
-  SIDE LINE LENGTH TO SEWERMAIN
-  OFFSET FROM SIDE BOUNDARY
-  INSIDE PROPERTY
-  SEWER INVERT LEVELS

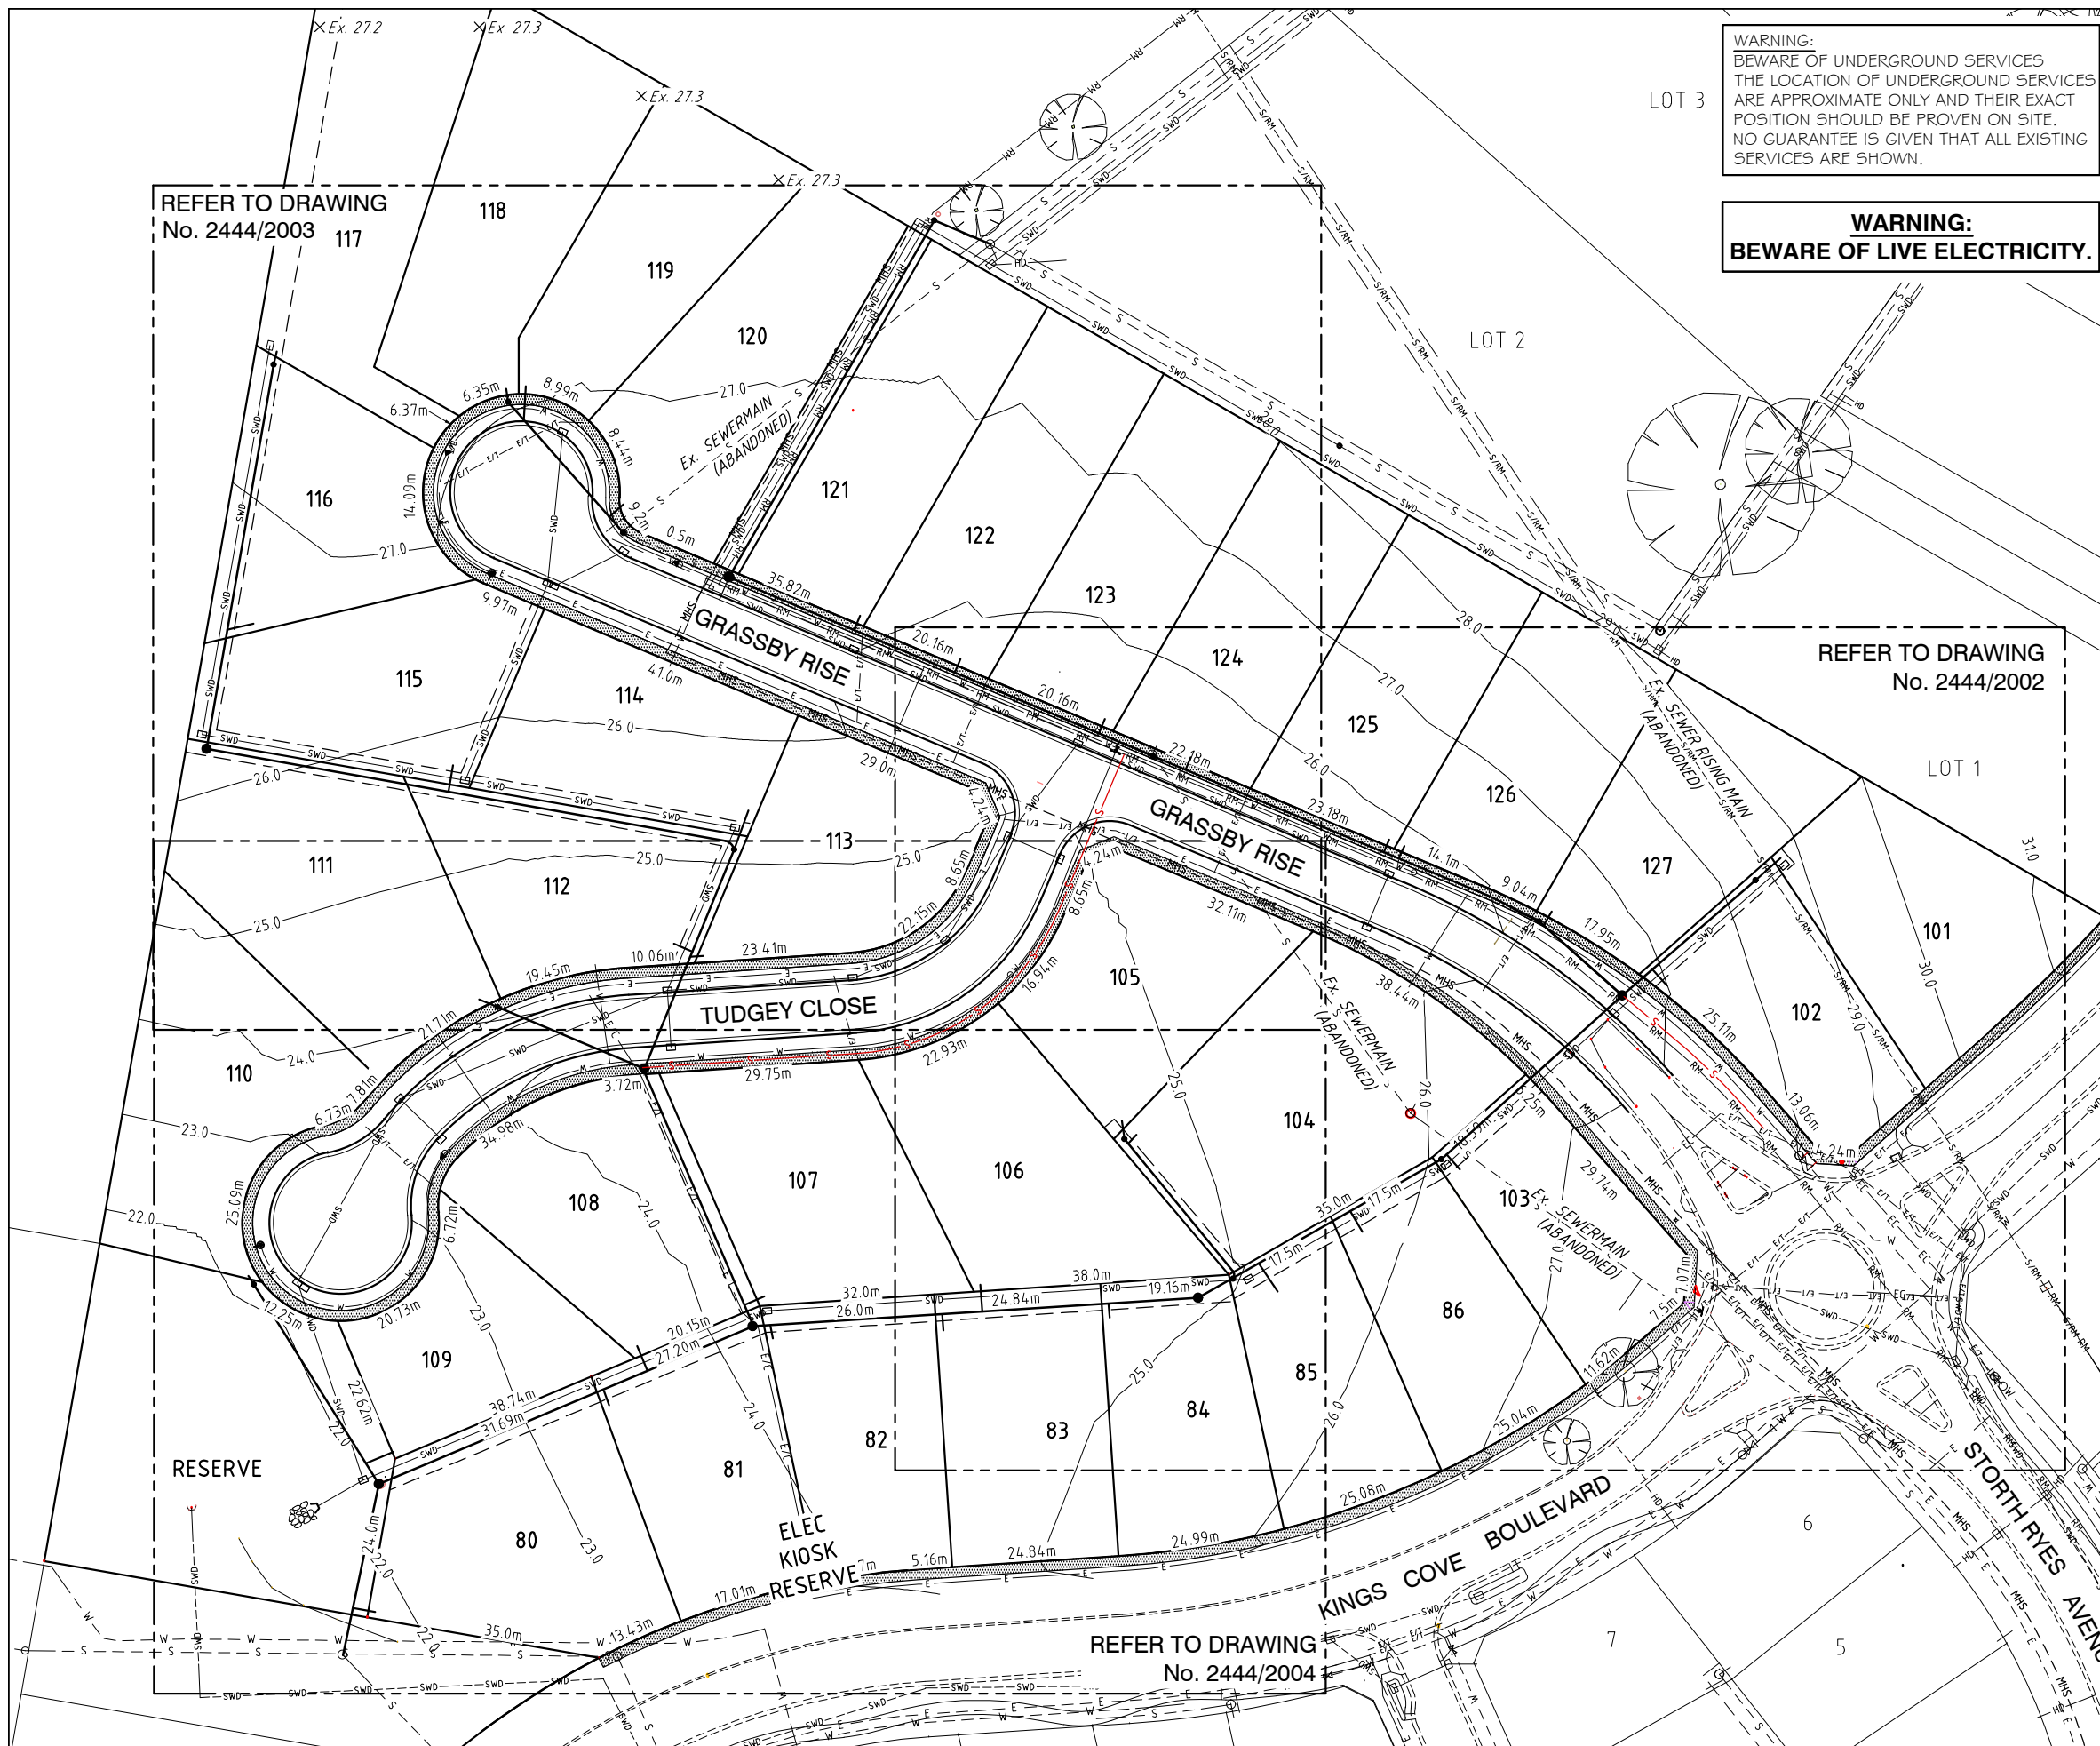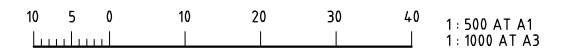

REV.	APPR.	DATE	REVISIONS
G	M.S.	15-03-2024	ISSUED TO CLIENT/AGENT
F	M.S.	19-06-2023	AS CONSTRUCTED INFORMATION ADDED
E	A.G.	05-04-2023	ISSUED FOR CONSTRUCTION - UPDATED SEWER ALIGNMENT
D	A.G.	05-12-2022	ISSUED FOR CONSTRUCTION
C	A.G.	22-06-2022	EAST GIPPSLAND WATER AMENDMENTS
B	A.G.	18-05-2022	EAST GIPPSLAND WATER AMENDMENTS
A	A.G.	6-01-2021	ORIGINAL ISSUE

© Crossco Consulting Pty Ltd All Rights Reserved 2022.
Copyright in the whole and every part of this drawing belongs to Crossco Consulting Pty Ltd and may not be used, sold, transferred, copied or reproduced in whole or in part in any manner or form or on any media, to any person other than by agreement with Crossco Consulting Pty Ltd.
This document is produced by Crossco Consulting Pty Ltd solely for the benefit of and use by the client in accordance with the terms of the retainer. Crossco Consulting Pty Ltd does not and shall not assume any responsibility or liability whatsoever to any third party arising out of any use or reliance by third party on the content of this document.

Crossco Consulting Pty Ltd
ABN: 88 135 548 110
154 Macleod St
P.O. Box 858
Bairnsdale Vic 3875
Tel: (03) 51526298
Fax: (03) 51527222
Email: consult@crossco.com.au



DESIGNED: A.G.
DRAWN: A.C.
CHECKED: A.G.
APPROVED: A.G.
SCALE: 1:500

A1 DATUM: A.H.D.


SURVEY REF: 20210601
PLAN No: PS 845531 E

XREF ATTACHED: R:\2444 Quaysone 120 KCB Metung\ACAD\Xref\2444 BP.dwg
CAD FILE NAME: R:\2444 Quaysone 120 KCB Metung\ACAD\Org\2444-2001.dwg

METUNG DEVELOPMENTS PTY LTD.
EAST GIPPSLAND WATER
THE WEDGE, KINGS COVE BOULEVARD, METUNG

DATE: MARCH 2022
SHEET 2 OF 17
DRAWING No: **2444/2001**

OVERALL LAYOUT PLAN

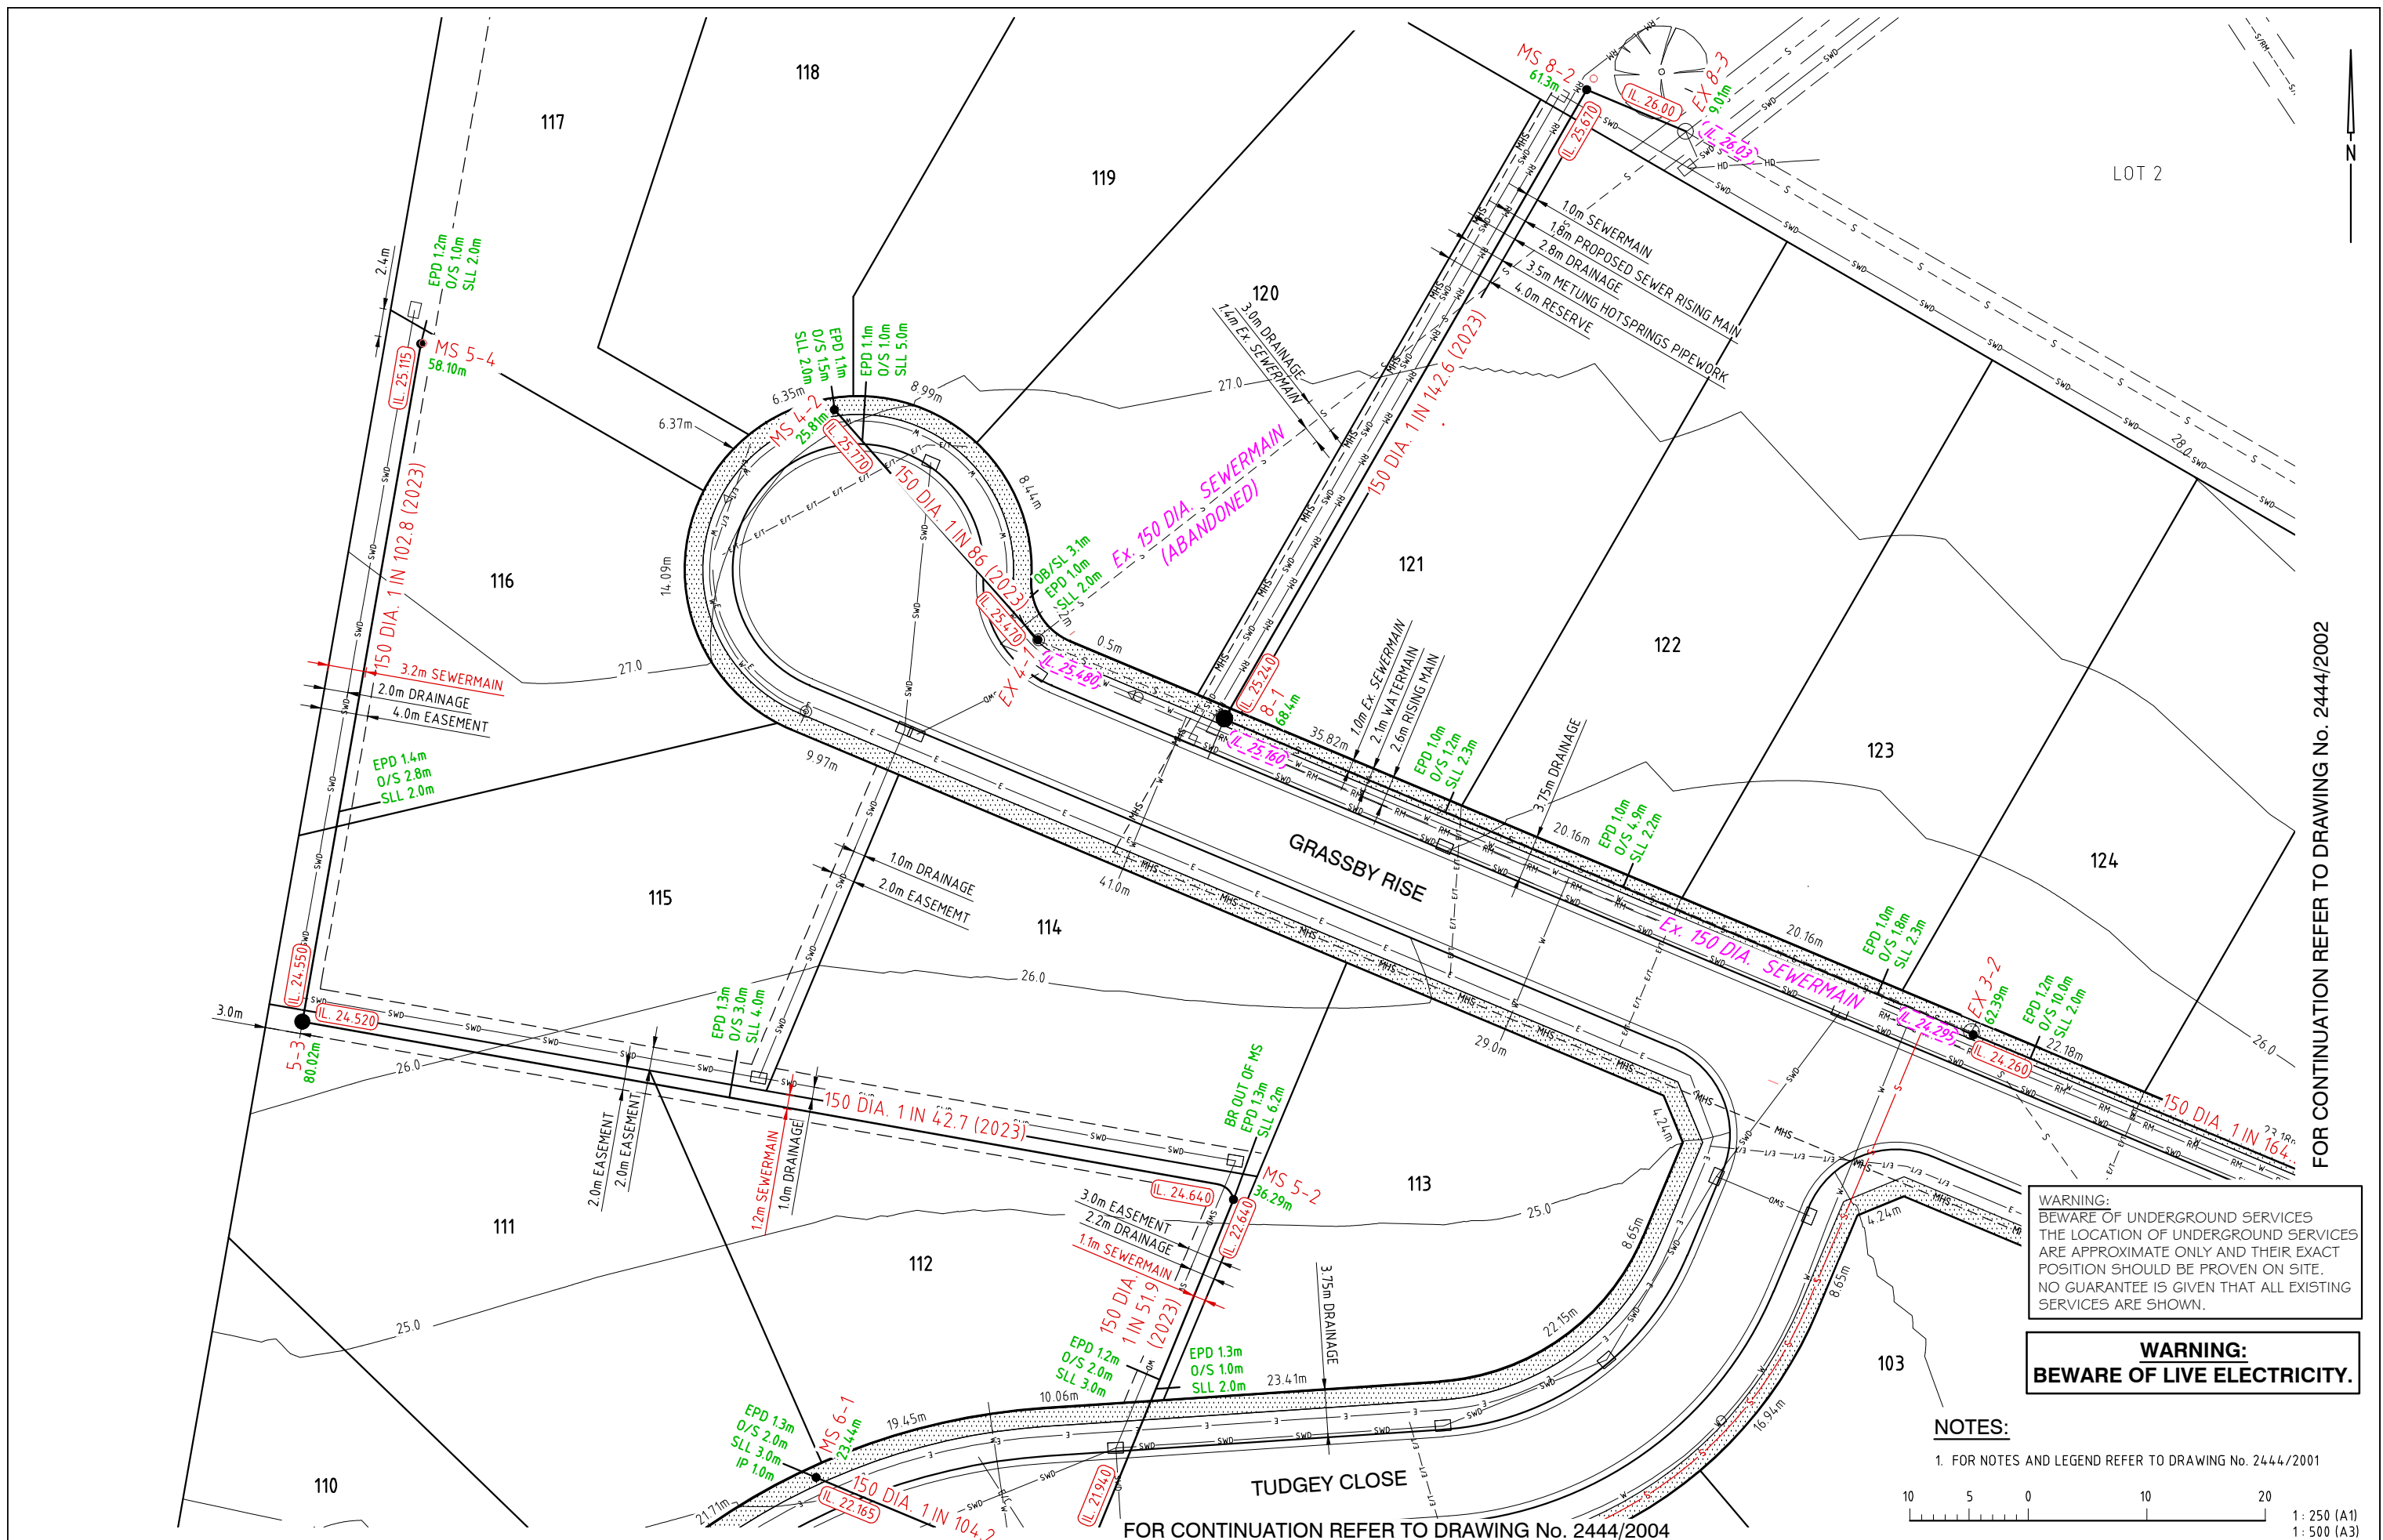

WARNING:
BEWARE OF UNDERGROUND SERVICES
THE LOCATION OF UNDERGROUND SERVICES
ARE APPROXIMATE ONLY AND THEIR EXACT
POSITION SHOULD BE PROVEN ON SITE.
NO GUARANTEE IS GIVEN THAT ALL EXISTING
SERVICES ARE SHOWN.

WARNING:
BEWARE OF LIVE ELECTRICITY.

NOTES:
1. FOR NOTES AND LEGEND REFER TO DRAWING No. 2444/2001

10 5 0 10 20
1:250 (A1)
1:500 (A3)

FOR CONTINUATION REFER TO DRAWING No. 2444/2002

FOR CONTINUATION REFER TO DRAWING No. 2444/2004

REV.	APPR.	DATE	REVISIONS
G	M.S.	15-03-2024	ISSUED TO CLIENT/AGENT
F	M.S.	19-06-2023	AS CONSTRUCTED INFORMATION ADDED
E	A.G.	05-04-2023	ISSUED FOR CONSTRUCTION - UPDATED SEWER ALIGNMENT
D	A.G.	05-12-2022	ISSUED FOR CONSTRUCTION
C	A.G.	22-06-2022	EAST GIPPSLAND WATER AMENDMENTS
B	A.G.	18-05-2022	EAST GIPPSLAND WATER AMENDMENTS
A	A.G.	6-01-2021	ORIGINAL ISSUE

© Crossco Consulting Pty Ltd All Rights Reserved 2022.
Copyright in the whole and every part of this drawing belongs to Crossco Consulting Pty Ltd and may not be used, sold, transferred, copied or reproduced in whole or in part in any manner or form or on any media, to any person other than by agreement with Crossco Consulting Pty Ltd.

This document is produced by Crossco Consulting Pty Ltd solely for the benefit of and use by the client in accordance with the terms of the retainer. Crossco Consulting Pty Ltd does not and shall not assume any responsibility or liability whatsoever to any third party arising out of any use or reliance by third party on the content of this document.

Crossco Consulting Pty Ltd
ABN: 88 135 548 110
154 Macleod St
P.O. Box 858
Bairnsdale Vic 3875
Tel: (03) 51526298
Fax: (03) 51527222
Email: consult@crossco.com.au


DESIGNED: A.G.	A1	DATUM: A.H.D.
DRAWN: A.C.		
CHECKED: A.G.		
APPROVED: A.G.	SURVEY REF: 20210601	
SCALE: 1:250	PLAN No: PS 845531 E	
XREF ATTACHED: R:\2444 Quaystone 120 KCB Metung\ACAD\Xref\2444_BP.dwg		
CAD FILE NAME: C:\Users\User\AppData\Local\Temp\AcPublish_32636\2444-2003.dwg		

METUNG DEVELOPMENTS PTY LTD.
EAST GIPPSLAND WATER
THE WEDGE, KINGS COVE BOULEVARD, METUNG

DATE: MARCH 2022
SHEET 4 OF 17
DRAWING No: **2444/2003**

DETAIL LAYOUT PLAN - SHEET 2 OF 3

FOR CONTINUATION REFER TO DRAWING No. 2444/2003

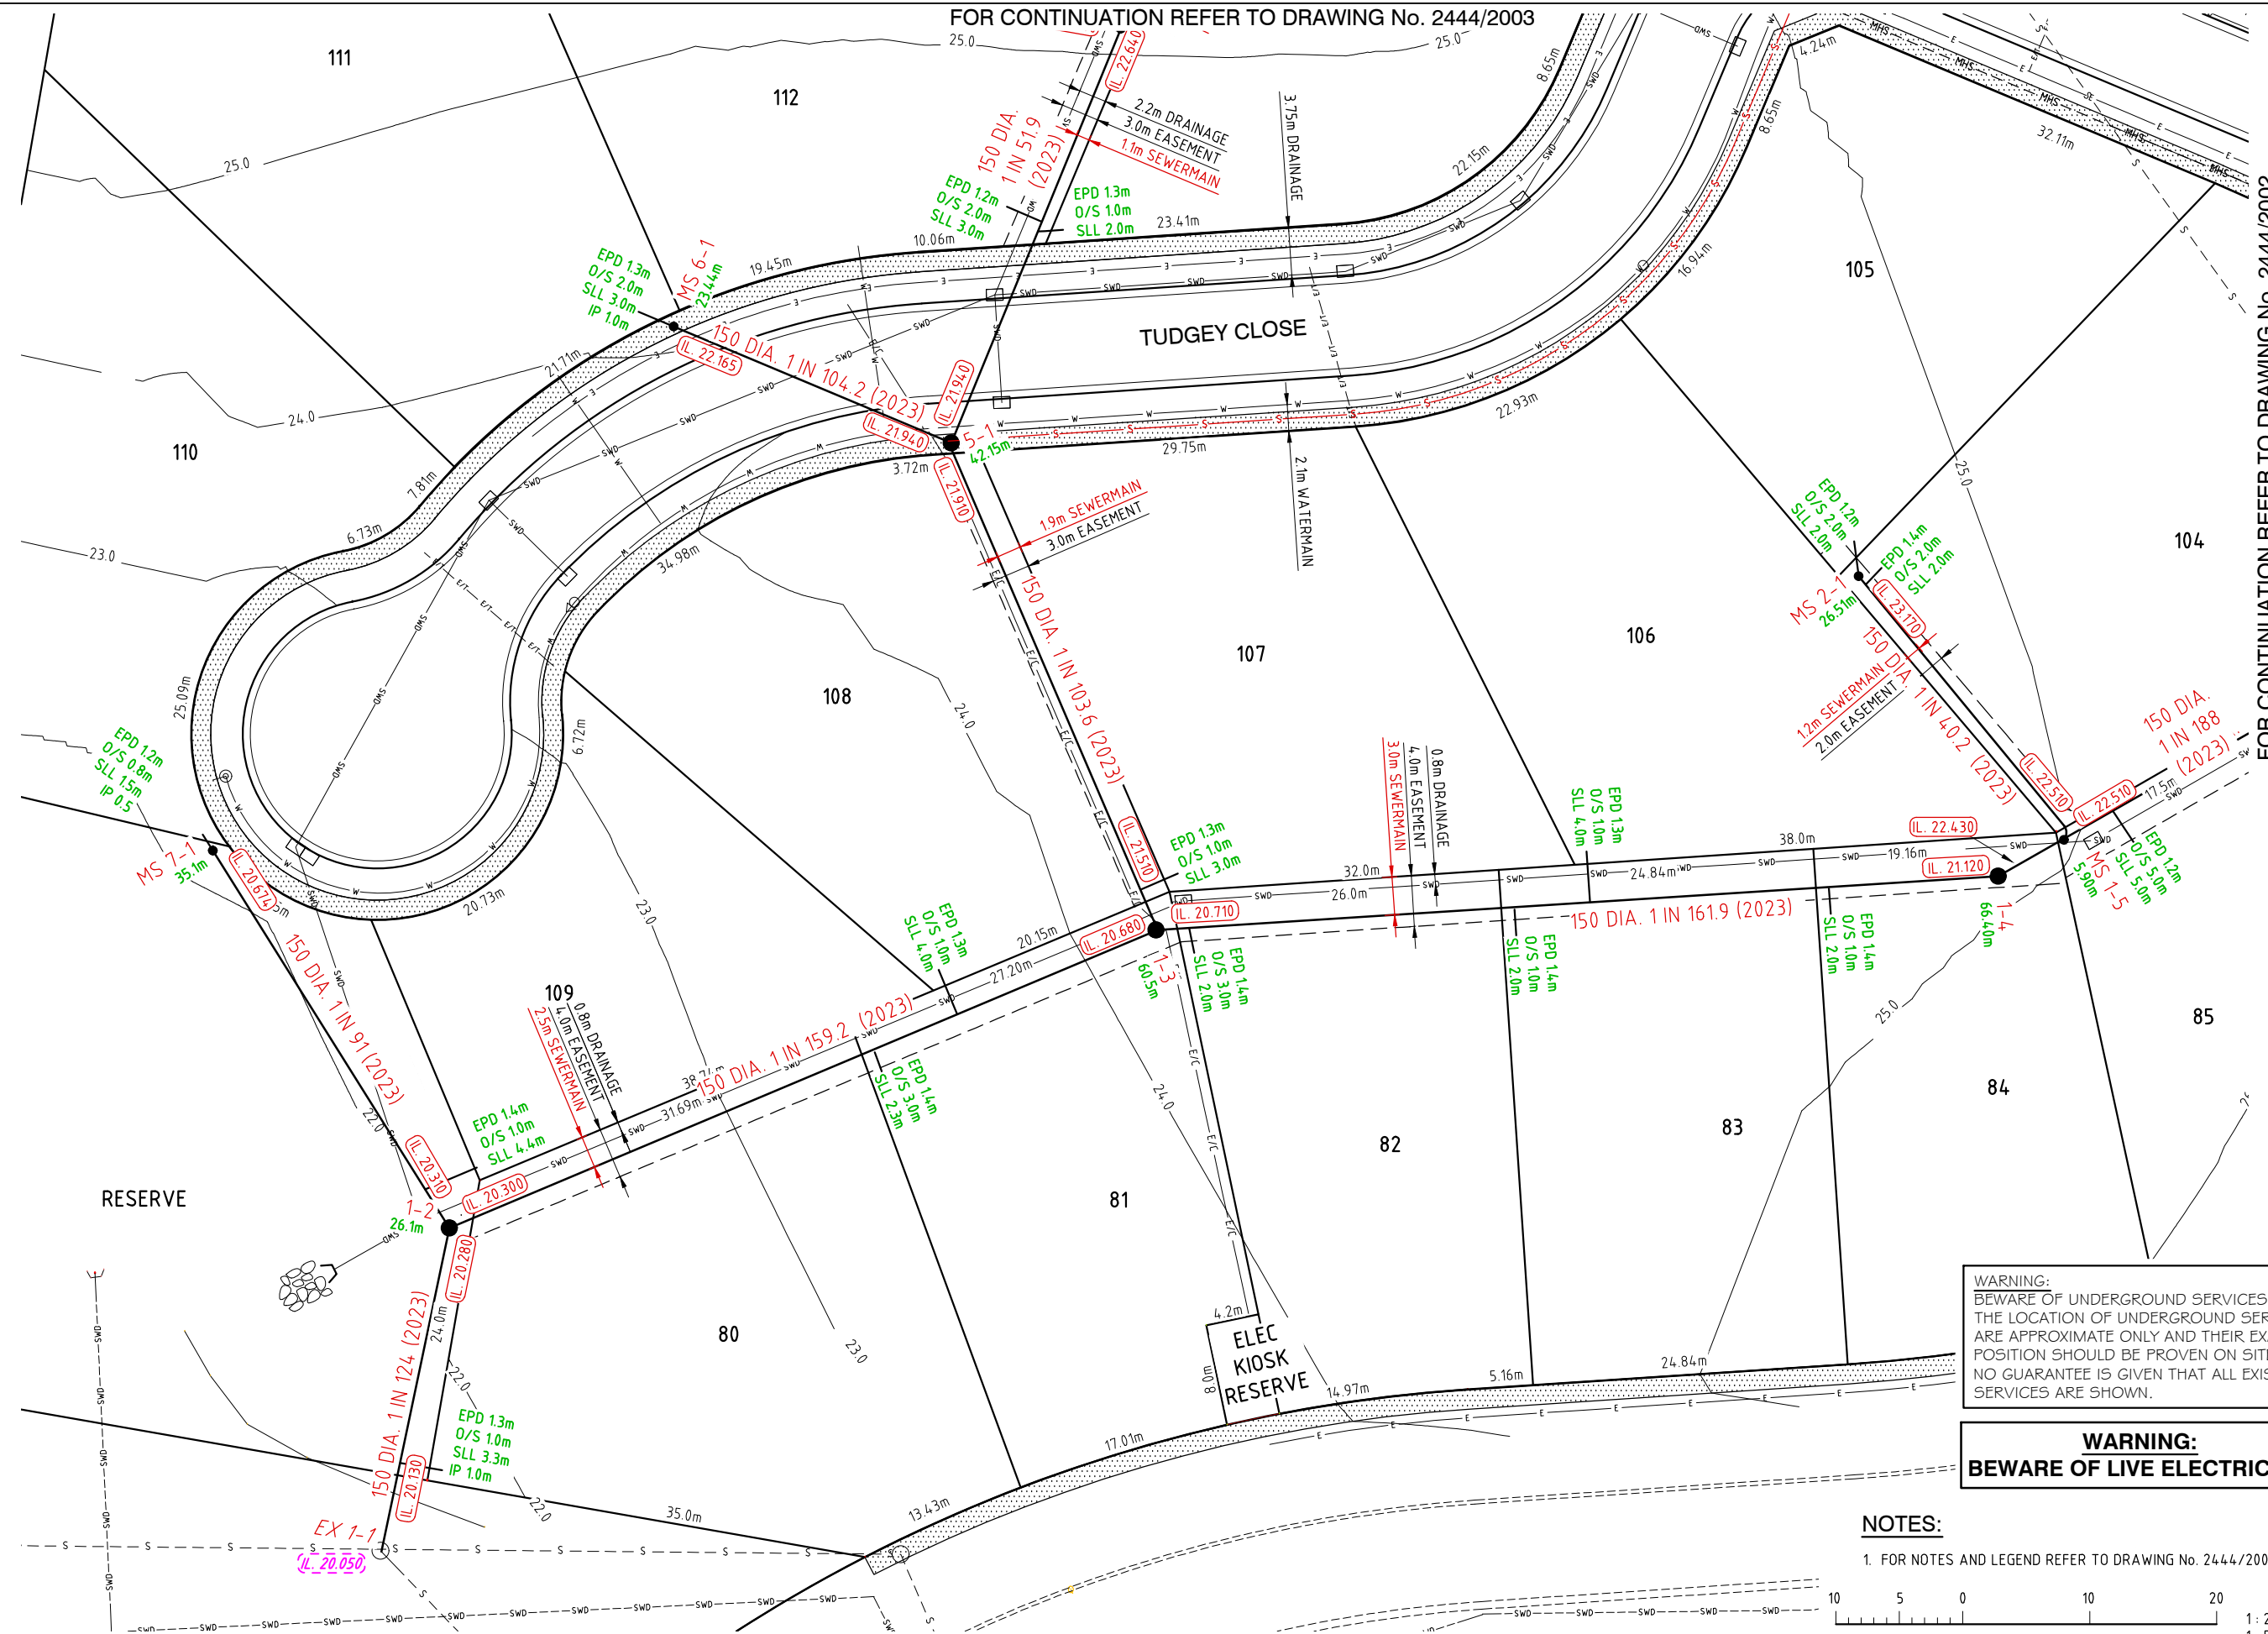

FOR CONTINUATION REFER TO DRAWING No. 2444/2002

WARNING:
BEWARE OF UNDERGROUND SERVICES
THE LOCATION OF UNDERGROUND SERVICES
ARE APPROXIMATE ONLY AND THEIR EXACT
POSITION SHOULD BE PROVEN ON SITE.
NO GUARANTEE IS GIVEN THAT ALL EXISTING
SERVICES ARE SHOWN.

WARNING:
BEWARE OF LIVE ELECTRICITY.

NOTES:
1. FOR NOTES AND LEGEND REFER TO DRAWING No. 2444/2001

1 : 250 (A1)
1 : 500 (A3)

Rv	APPR	DATE	REVISIONS
G	M.S.	15-03-2024	ISSUED TO CLIENT/AGENT
F	M.S.	19-06-2023	AS CONSTRUCTED INFORMATION ADDED
E	A.G.	05-04-2023	ISSUED FOR CONSTRUCTION - UPDATED SEWER ALIGNMENT
D	A.G.	05-12-2022	ISSUED FOR CONSTRUCTION
C	A.G.	22-06-2022	EAST GIPPSLAND WATER AMENDMENTS
B	A.G.	18-05-2022	EAST GIPPSLAND WATER AMENDMENTS
A	A.G.	6-01-2021	ORIGINAL ISSUE

© Crossco Consulting Pty Ltd All Rights Reserved 2022.
Copyright in the whole and every part of this drawing belongs to Crossco Consulting Pty Ltd and may not be used, sold, transferred, copied or reproduced in whole or in part in any manner or form or on any media, to any person other than by agreement with Crossco Consulting Pty Ltd.


This document is produced by Crossco Consulting Pty Ltd solely for the benefit of and use by the client in accordance with the terms of the retainer. Crossco Consulting Pty Ltd does not and shall not assume any responsibility or liability whatsoever to any third party arising out of any use or reliance by third party on the content of this document.

Crossco Consulting Pty Ltd
ABN: 88 135 548 110
154 Macleod St
P.O. Box 858
Bairnsdale Vic 3875
Tel: (03) 51526298
Fax: (03) 51527222
Email: consult@crossco.com.au



DESIGNED: A.G.	A1	DATUM: A.H.D.
DRAWN: A.C.		
CHECKED: A.G.		
APPROVED: A.G.	SURVEY REF: 20210601	
SCALE: 1:250	PLAN No: PS 845531 E	
XREF ATTACHED: R:\2444 Quaystone 120 KCB Metung\ACAD\Xref\2444_BP.dwg		
CAD FILE NAME: R:\2444 Quaystone 120 KCB Metung\ACAD\Org\2444-2004.dwg		

METUNG DEVELOPMENTS PTY LTD.		
EAST GIPPSLAND WATER		
THE WEDGE, KINGS COVE BOULEVARD, METUNG		DATE: MARCH 2022
		SHEET 5 OF 17
		DRAWING No:
DETAIL LAYOUT PLAN - SHEET 3 OF 3		2444/2004

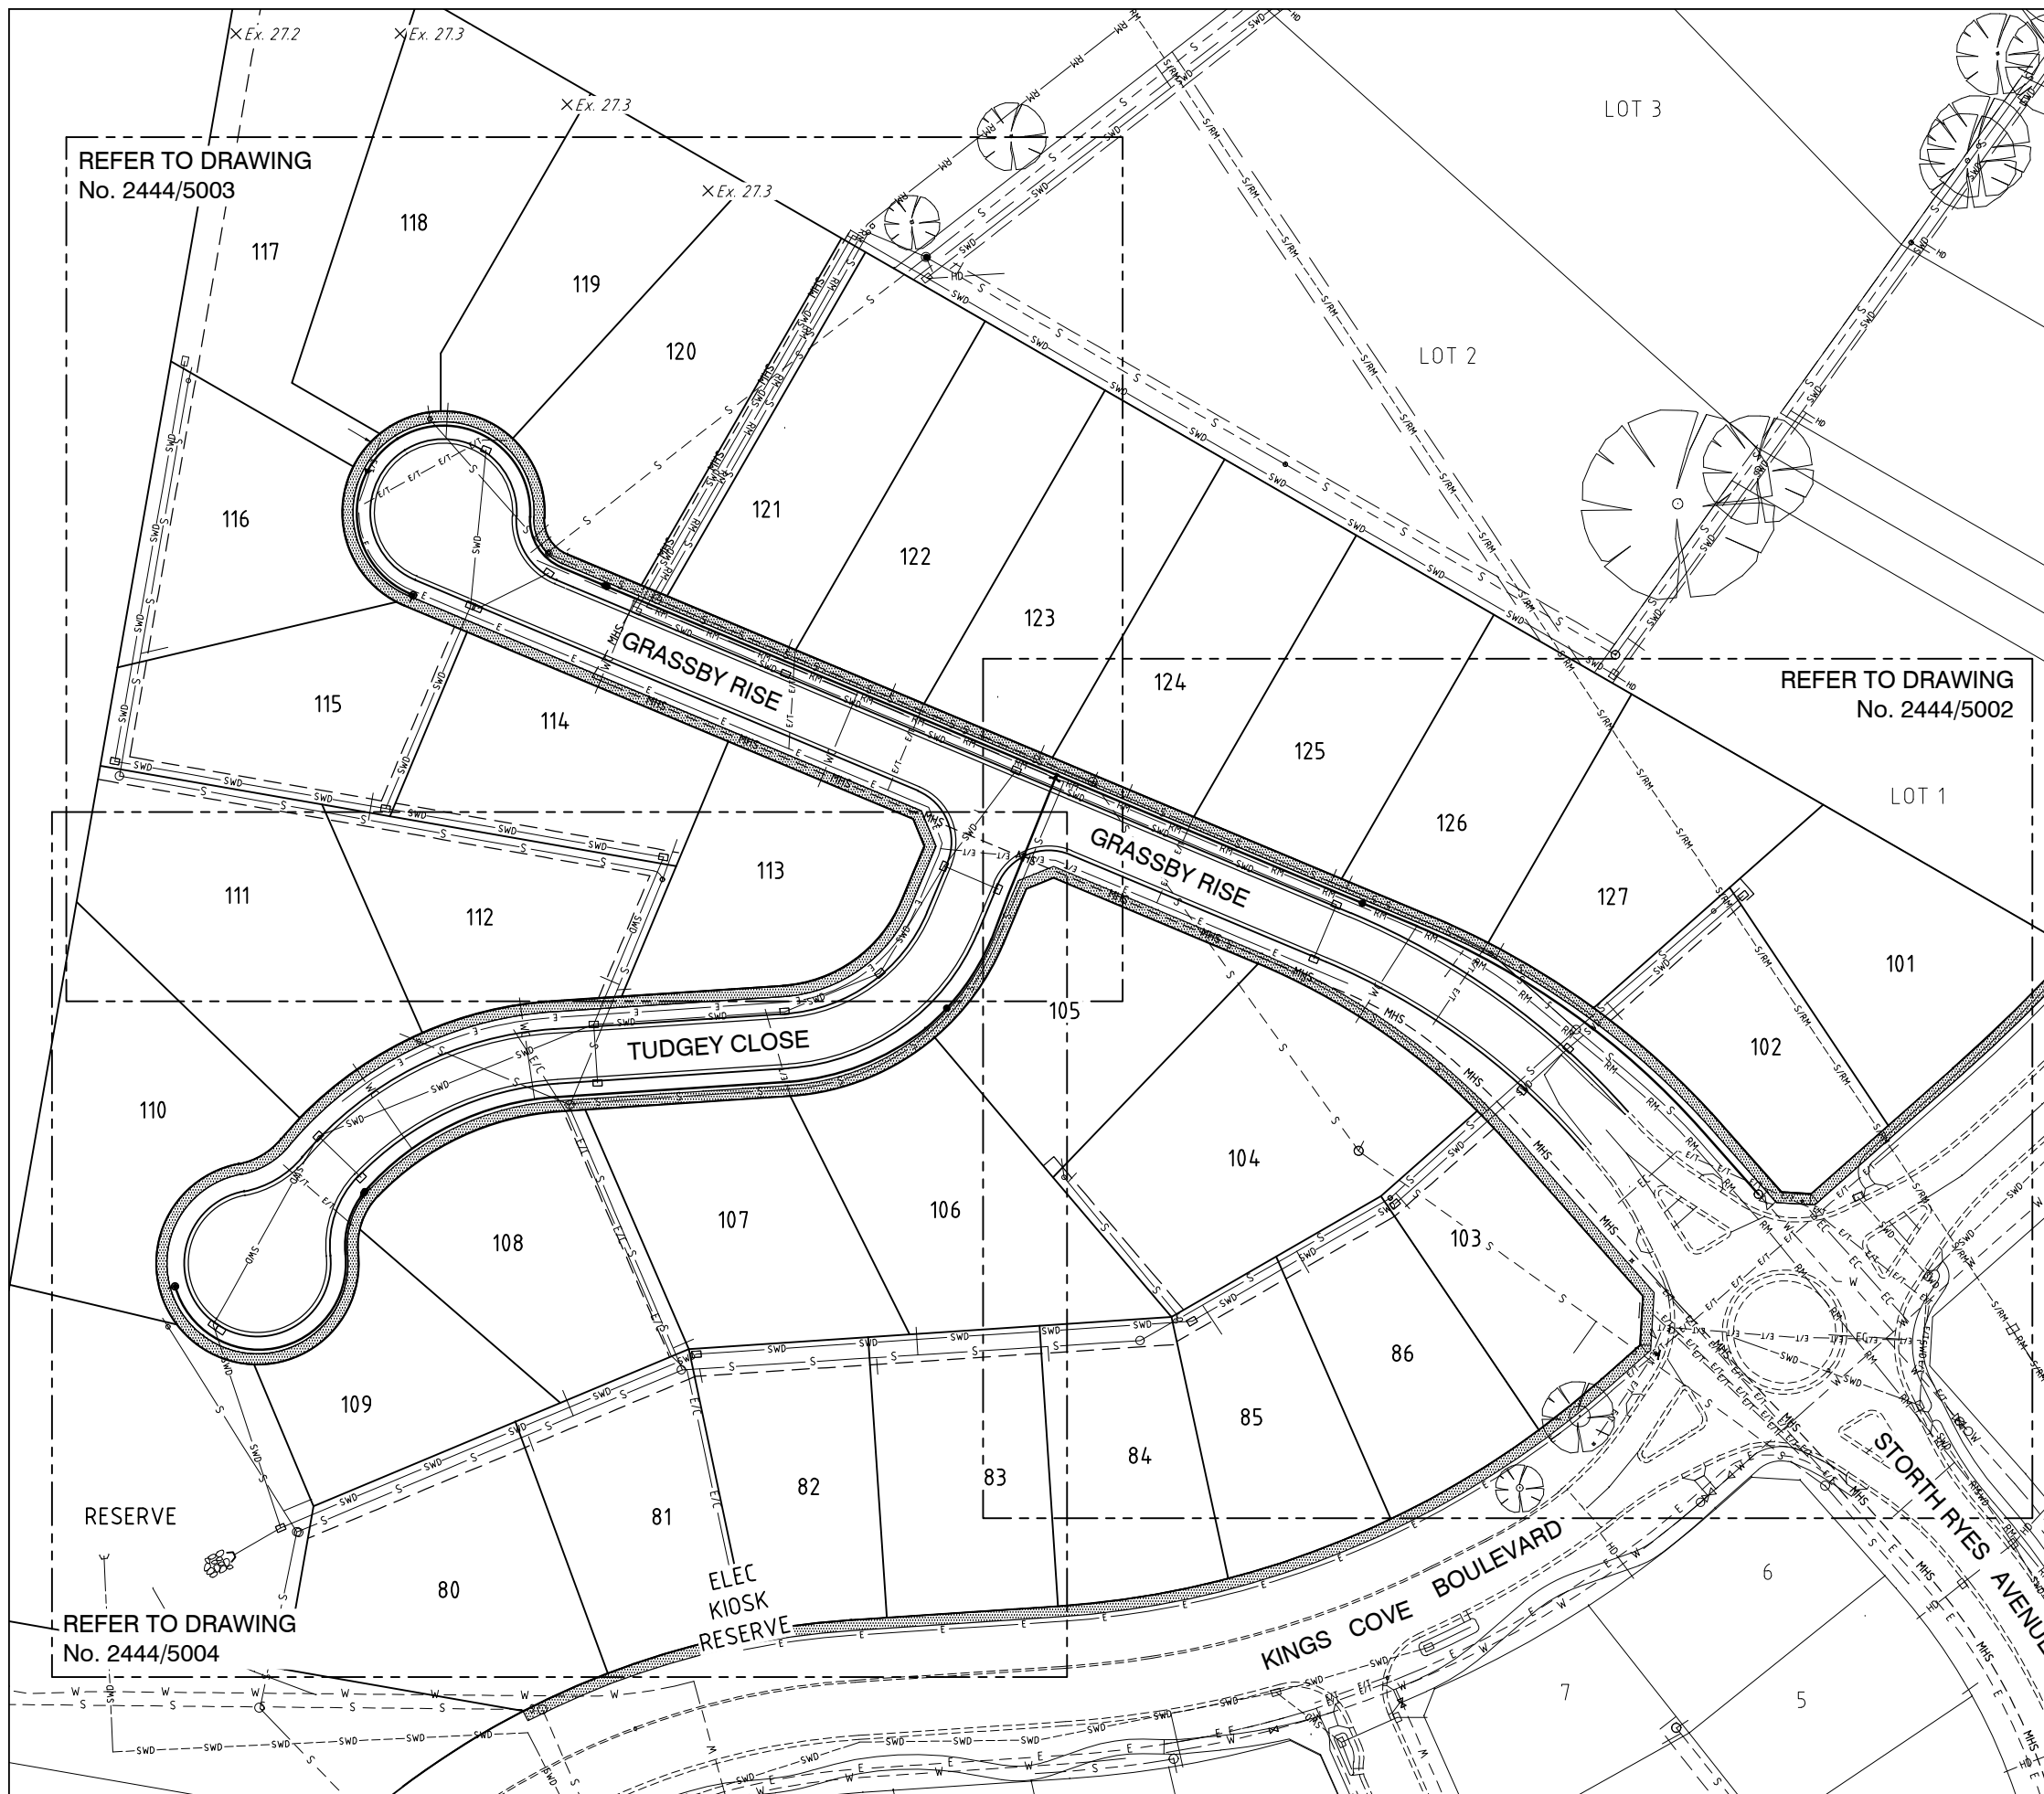

WARNING:
BEWARE OF UNDERGROUND SERVICES
THE LOCATION OF UNDERGROUND SERVICES
ARE APPROXIMATE ONLY AND THEIR EXACT
POSITION SHOULD BE PROVEN ON SITE.
NO GUARANTEE IS GIVEN THAT ALL EXISTING
SERVICES ARE SHOWN.

WARNING:
BEWARE OF LIVE ELECTRICITY.




REFER TO DRAWING
No. 2444/5002

REFER TO DRAWING
No. 2444/5003

REFER TO DRAWING
No. 2444/5004

**FRITH'S PLUMBING & CIVIL PTY LTD
(CONTRACTOR)
HAVE UNDERTAKEN THESE WORKS**

- LEGEND :**
- CONSTRUCTED WATERMAIN
 - CONSTRUCTED FIRE HYDRANT
 - CONSTRUCTED REDUCER
 - CONSTRUCTED SLUICE VALVE
 - CONSTRUCTED FLUSHING POINT
 - CONSTRUCTED PUDDLE FLANGE

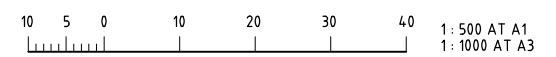

Rv	APPR	DATE	REVISIONS
G	M.S.	15-03-2024	ISSUED TO CLIENT/AGENT
F	M.S.	19-06-2023	AS CONSTRUCTED INFORMATION ADDED
E	A.G.	05-04-2023	ISSUED FOR CONSTRUCTION - UPDATED SEWER ALIGNMENT
D	A.G.	05-12-2022	ISSUED FOR CONSTRUCTION
C	A.G.	22-06-2022	EAST GIPPSLAND WATER AMENDMENTS
B	A.G.	18-05-2022	EAST GIPPSLAND WATER AMENDMENTS
A	A.G.	6-01-2021	ORIGINAL ISSUE

© Crossco Consulting Pty Ltd All Rights Reserved 2022.
Copyright in the whole and every part of this drawing belongs to Crossco Consulting Pty Ltd and may not be used, sold, transferred, copied or reproduced in whole or in part in any manner or form or on any media, to any person other than by agreement with Crossco Consulting Pty Ltd.

This document is produced by Crossco Consulting Pty Ltd solely for the benefit of and use by the client in accordance with the terms of the retainer. Crossco Consulting Pty Ltd does not and shall not assume any responsibility or liability whatsoever to any third party arising out of any use or reliance by third party on the content of this document.

Crossco Consulting Pty Ltd
ABN: 88 135 548 110
154 Macleod St
P.O. Box 858
Bairnsdale Vic 3875
Tel: (03) 51526298
Fax: (03) 51527222
Email: consult@crossco.com.au

DESIGNED: A.G.	A1	DATUM: A.H.D.
DRAWN: A.C.		
CHECKED: A.G.	SURVEY REF: 20210601	
APPROVED: A.G.	PLAN No: PS 845531 E	
SCALE: 1:500		
XREF ATTACHED: R:\2444 Quaysone 120 KCB Metung\ACAD\Xref\2444 BP.dwg		
CAD FILE NAME: R:\2444 Quaysone 120 KCB Metung\ACAD\Org\2444-5001.dwg		

METUNG DEVELOPMENTS PTY LTD.
EAST GIPPSLAND WATER
THE WEDGE, KINGS COVE BOULEVARD, METUNG


DATE: MARCH 2022
SHEET 12 OF 17
DRAWING No: **2444/5001**

**WATERMAIN
OVERALL LAYOUT PLAN**

WARNING:
BEWARE OF UNDERGROUND SERVICES
THE LOCATION OF UNDERGROUND SERVICES
ARE APPROXIMATE ONLY AND THEIR EXACT
POSITION SHOULD BE PROVEN ON SITE.
NO GUARANTEE IS GIVEN THAT ALL EXISTING
SERVICES ARE SHOWN.


WARNING:
BEWARE OF LIVE ELECTRICITY.

FOR CONTINUATION REFER TO DRAWING NO. 2444/5003

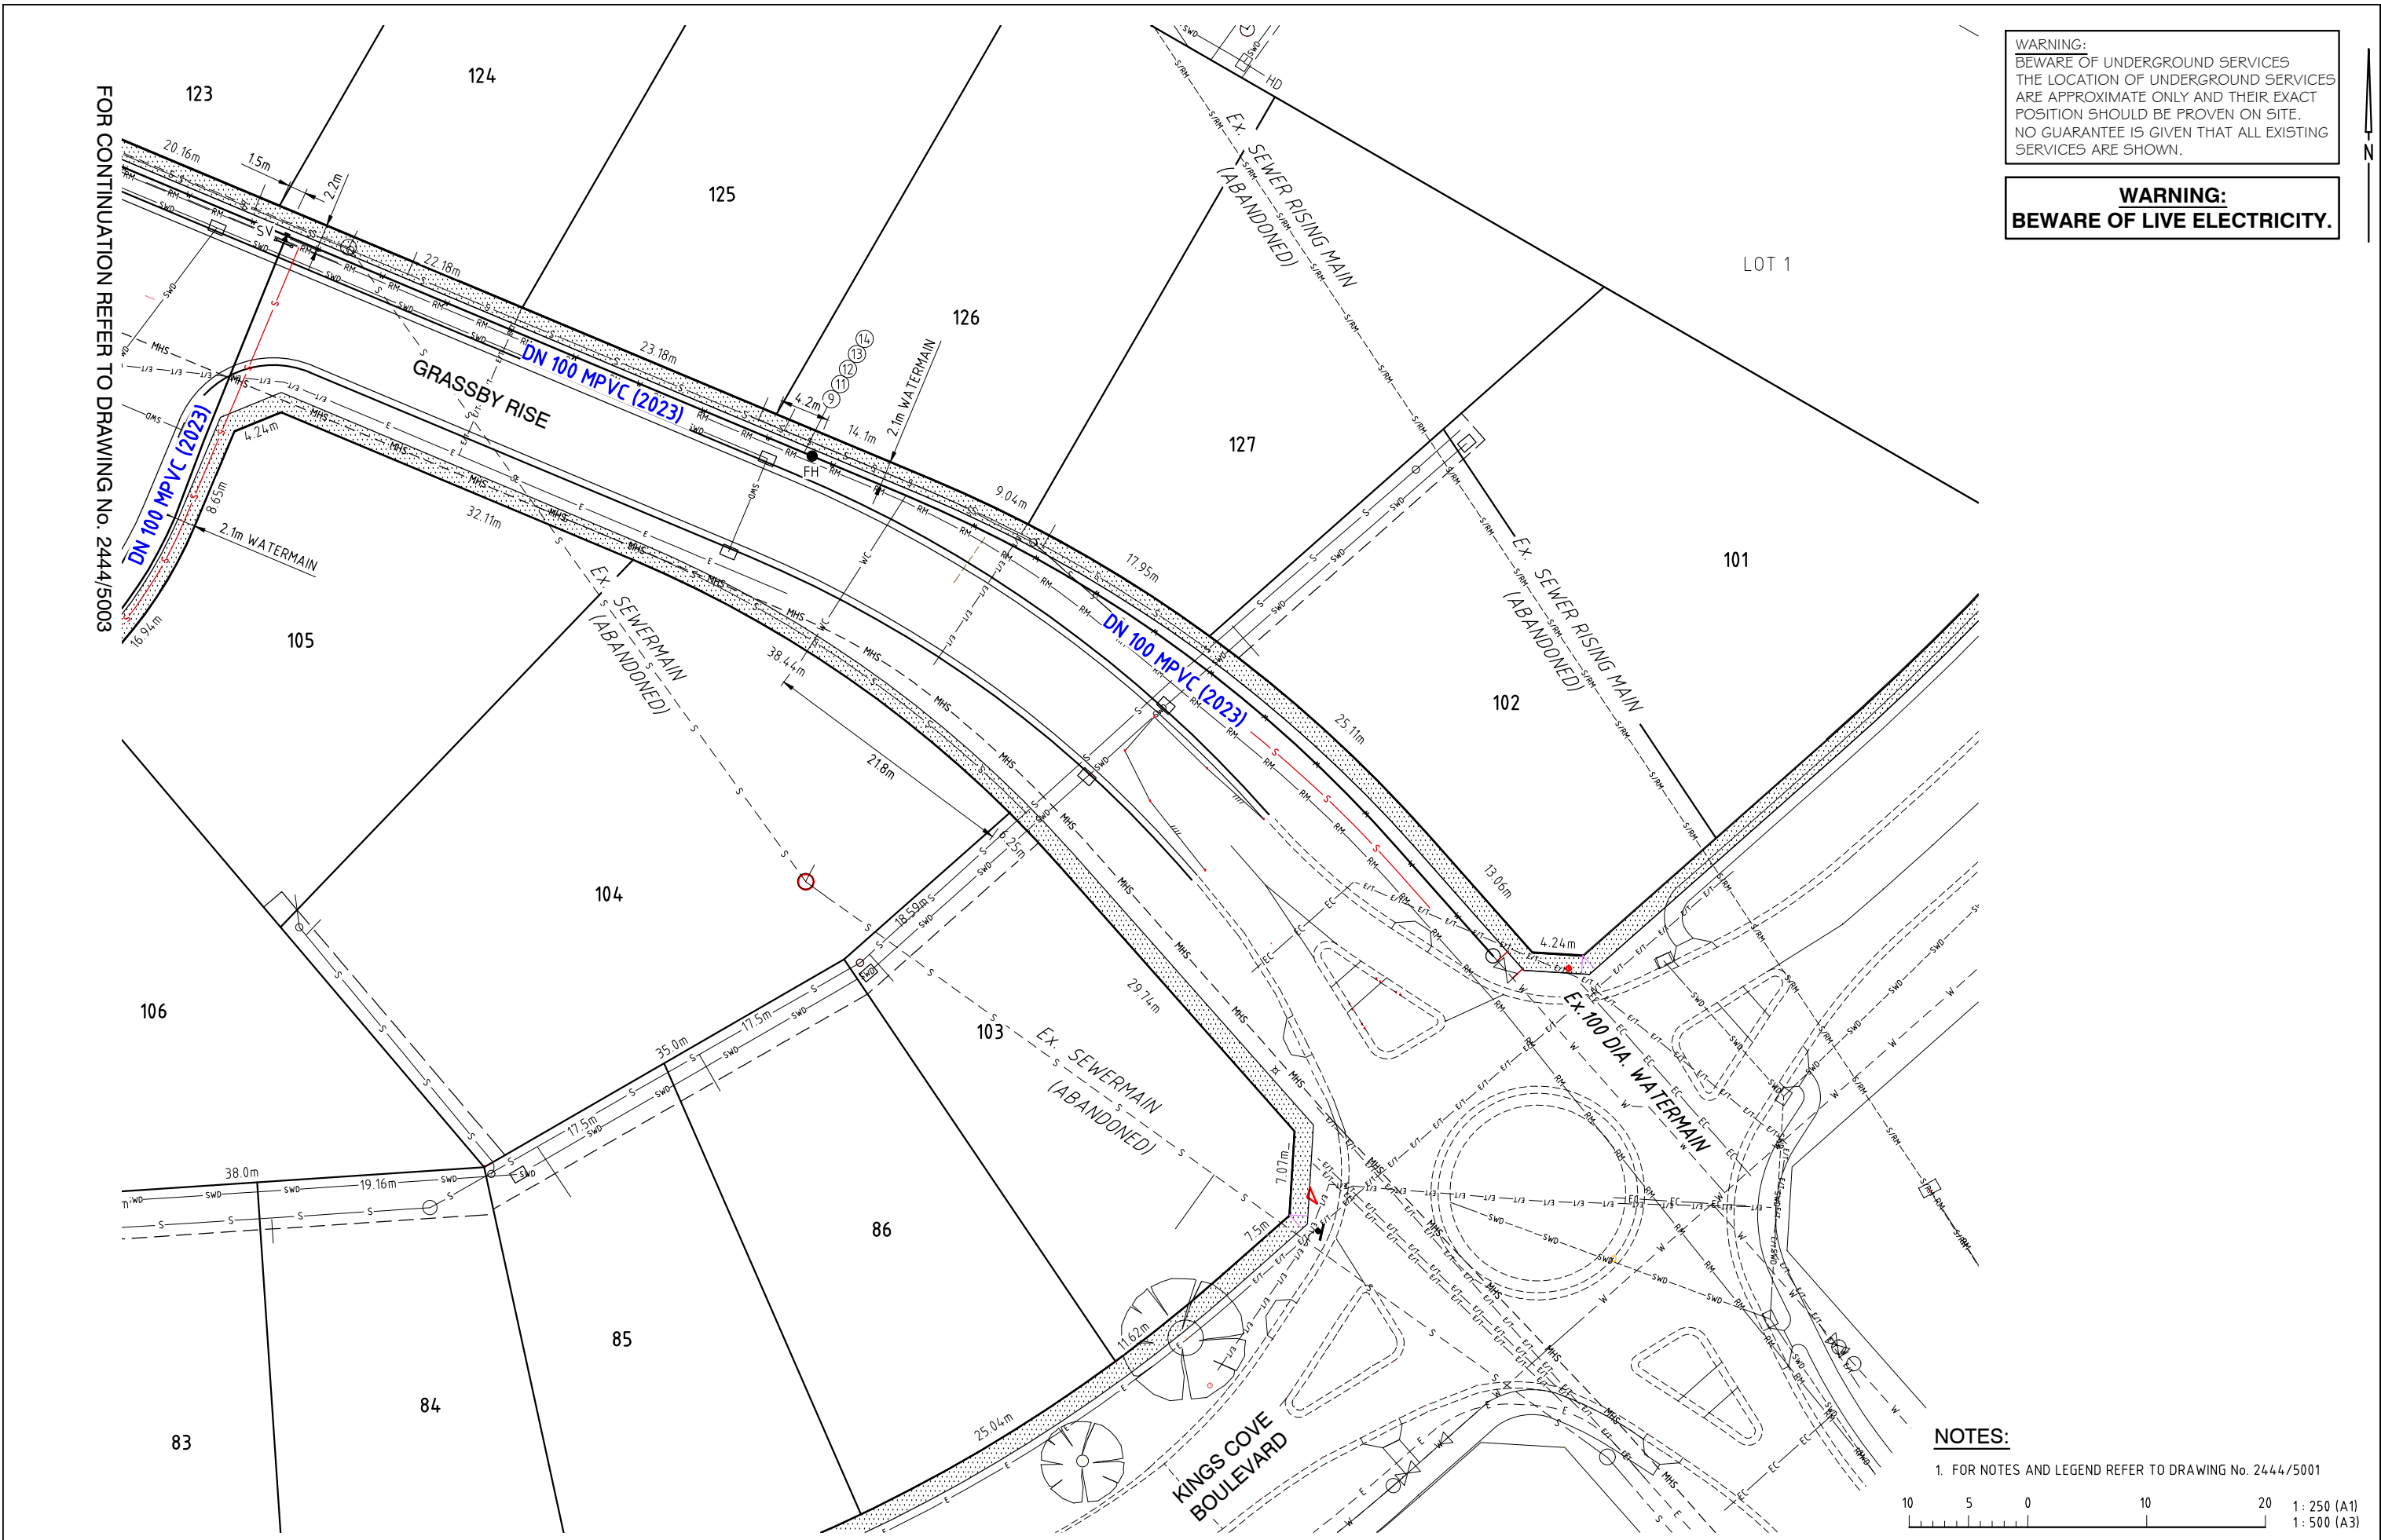

NOTES:

1. FOR NOTES AND LEGEND REFER TO DRAWING No. 2444/5001

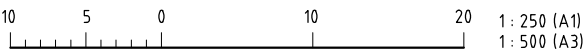

Rv	APPR	DATE	REVISIONS
G	M.S.	15-03-2024	ISSUED TO CLIENT / AGENT
F	M.S.	19-06-2023	AS CONSTRUCTED INFORMATION ADDED
E	A.G.	05-04-2023	ISSUED FOR CONSTRUCTION - UPDATED SEWER ALIGNMENT
D	A.G.	05-12-2022	ISSUED FOR CONSTRUCTION
C	A.G.	22-06-2022	EAST GIPPSLAND WATER AMENDMENTS
B	A.G.	18-05-2022	EAST GIPPSLAND WATER AMENDMENTS
A	A.G.	6-01-2021	ORIGINAL ISSUE

© Crossco Consulting Pty Ltd All Rights Reserved 2022.
Copyright in the whole and every part of this drawing belongs to Crossco Consulting Pty Ltd and may not be used, sold, transferred, copied or reproduced in whole or in part in any manner or form on any media, to any person other than by agreement with Crossco Consulting Pty Ltd.

This document is produced by Crossco Consulting Pty Ltd solely for the benefit of and use by the client in accordance with the terms of the retainer. Crossco Consulting Pty Ltd does not and shall not assume any responsibility or liability whatsoever to any third party arising out of any use or reliance by third party on the content of this document.


Crossco Consulting Pty Ltd
ABN: 88 135 548 110
154 Macleod St
P.O. Box 858
Bairnsdale Vic 3875
Tel: (03) 51526298
Fax: (03) 51527222
Email: consult@crossco.com.au

DESIGNED: A.G.	A1	DATUM: A.H.D
DRAWN: A.C.		
CHECKED: A.G.	SURVEY REF: 20210601	
APPROVED: A.G.	PLAN No: PS 845531 E	
SCALE: 1:250		
XREF ATTACHED: R:\2444 Quaysone 120 KCB Metung\ACAD\Xref\2444_BP.dwg		
CAD FILE NAME: R:\2444 Quaysone 120 KCB Metung\ACAD\Drwg\2444-5002.dwg		

METUNG DEVELOPMENTS PTY LTD.
EAST GIPPSLAND WATER
THE WEDGE, KINGS COVE BOULEVARD, METUNG

DATE: MARCH 2022
SHEET 13 OF 17
DRAWING No: **2444/5002**

WATERMAIN
DETAIL LAYOUT PLAN - SHEET 1 OF 3

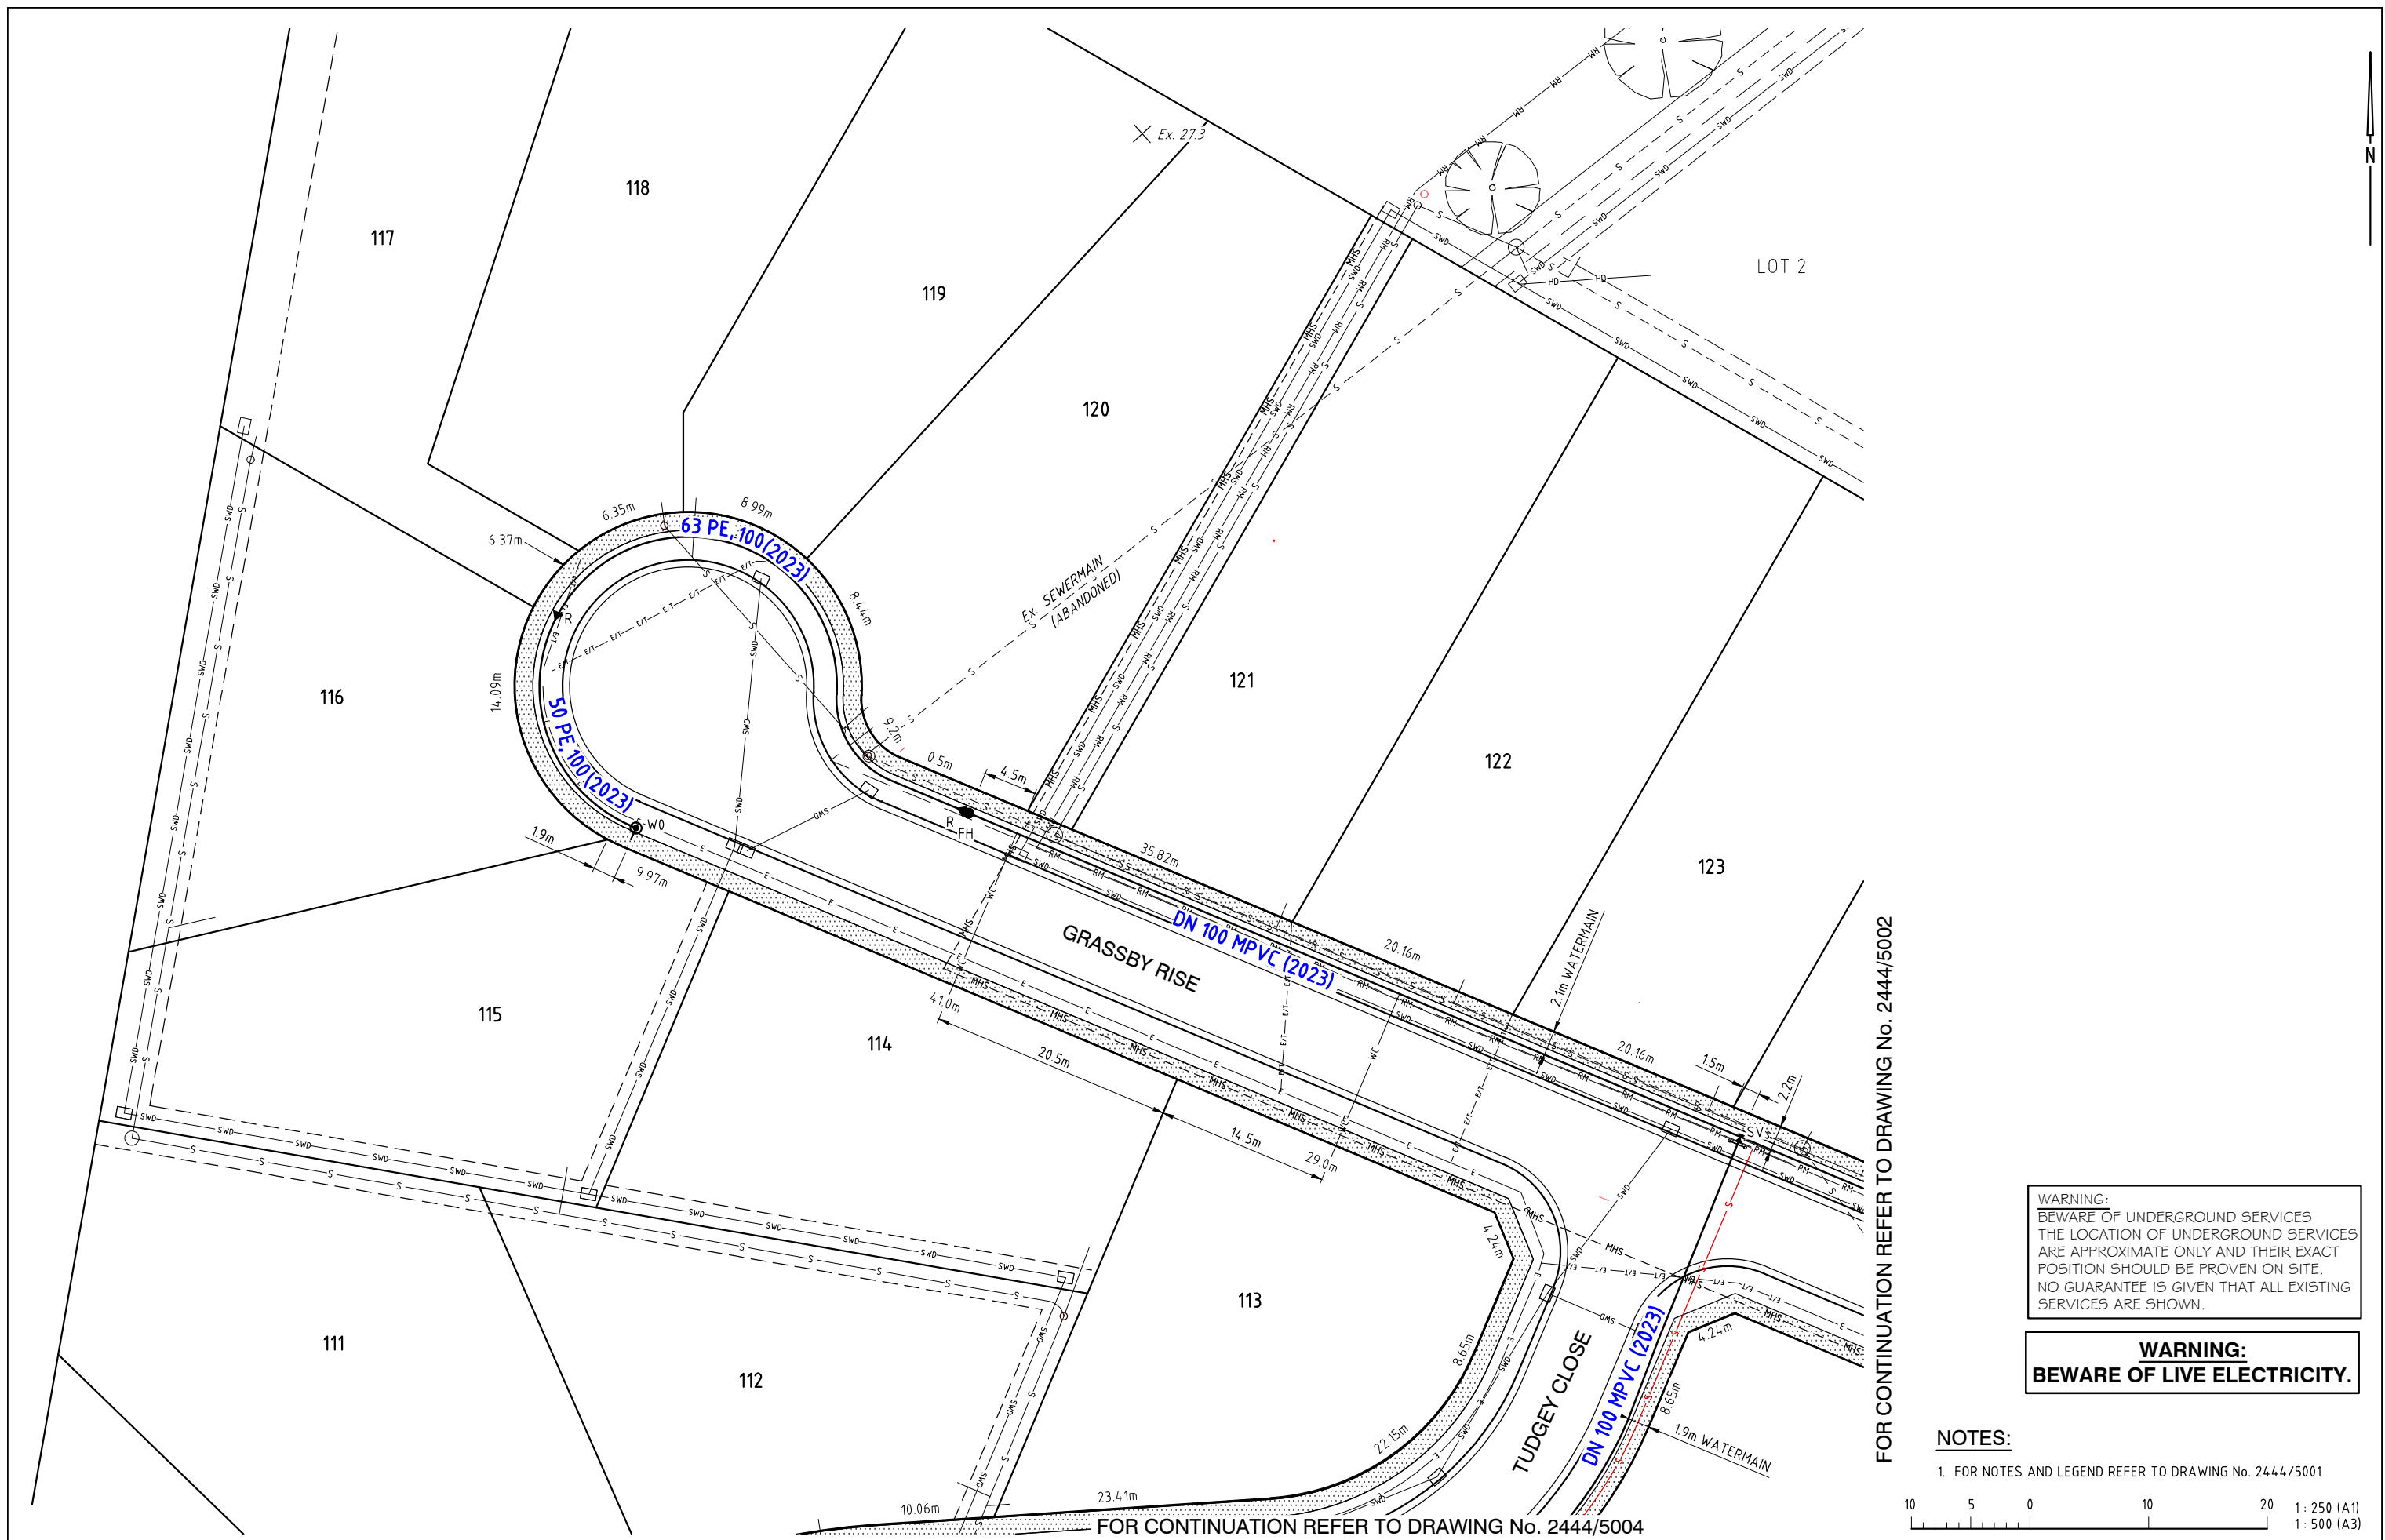


FOR CONTINUATION REFER TO DRAWING No. 2444/5002

WARNING:
BEWARE OF UNDERGROUND SERVICES
THE LOCATION OF UNDERGROUND SERVICES
ARE APPROXIMATE ONLY AND THEIR EXACT
POSITION SHOULD BE PROVEN ON SITE.
NO GUARANTEE IS GIVEN THAT ALL EXISTING
SERVICES ARE SHOWN.

WARNING:
BEWARE OF LIVE ELECTRICITY.

NOTES:

- FOR NOTES AND LEGEND REFER TO DRAWING No. 2444/5001

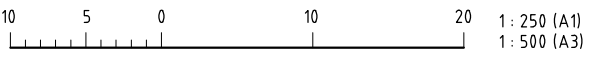

FOR CONTINUATION REFER TO DRAWING No. 2444/5004

Rv	APPR	DATE	REVISIONS
G	M.S.	15-03-2024	ISSUED TO CLIENT/AGENT
F	M.S.	19-06-2023	AS CONSTRUCTED INFORMATION ADDED
E	A.G.	05-04-2023	ISSUED FOR CONSTRUCTION - UPDATED SEWER ALIGNMENT
D	A.G.	05-12-2022	ISSUED FOR CONSTRUCTION
C	A.G.	22-06-2022	EAST GIPPSLAND WATER AMENDMENTS
B	A.G.	18-05-2022	EAST GIPPSLAND WATER AMENDMENTS
A	A.G.	6-01-2021	ORIGINAL ISSUE

© Crossco Consulting Pty Ltd All Rights Reserved 2022.
Copyright in the whole and every part of this drawing belongs to Crossco Consulting Pty Ltd and may not be used, sold, transferred, copied or reproduced in whole or in part in any manner or form or on any media, to any person other than by agreement with Crossco Consulting Pty Ltd.

This document is produced by Crossco Consulting Pty Ltd solely for the benefit of and use by the client in accordance with the terms of the retainer. Crossco Consulting Pty Ltd does not and shall not assume any responsibility or liability whatsoever to any third party arising out of any use or reliance by third party on the content of this document.

Crossco Consulting Pty Ltd
ABN: 88 135 548 110
154 Macleod St
P.O. Box 858
Bairnsdale Vic 3875
Tel: (03) 51526298
Fax: (03) 51527222
Email: consult@crossco.com.au




DESIGNED: A.G.	A1	DATUM: A.H.D.
DRAWN: A.C.		
CHECKED: A.G.	SURVEY REF: 20210601	
APPROVED: A.G.	PLAN No: PS 845531 E	
SCALE: 1:250		
XREF ATTACHED: R:\2444 Quaystone 120 KCB Metung\ACAD\Xref\2444_BP.dwg		
CAD FILE NAME: R:\2444 Quaystone 120 KCB Metung\ACAD\Org\2444-5003.dwg		

METUNG DEVELOPMENTS PTY LTD.	
EAST GIPPSLAND WATER	
THE WEDGE, KINGS COVE BOULEVARD, METUNG	
DATE: MARCH 2022	2444/5003
SHEET 14 OF 17	
DRAWING No:	

FOR CONTINUATION REFER TO DRAWING No. 2444/5003

FOR CONTINUATION REFER TO DRAWING No. 2444/5002

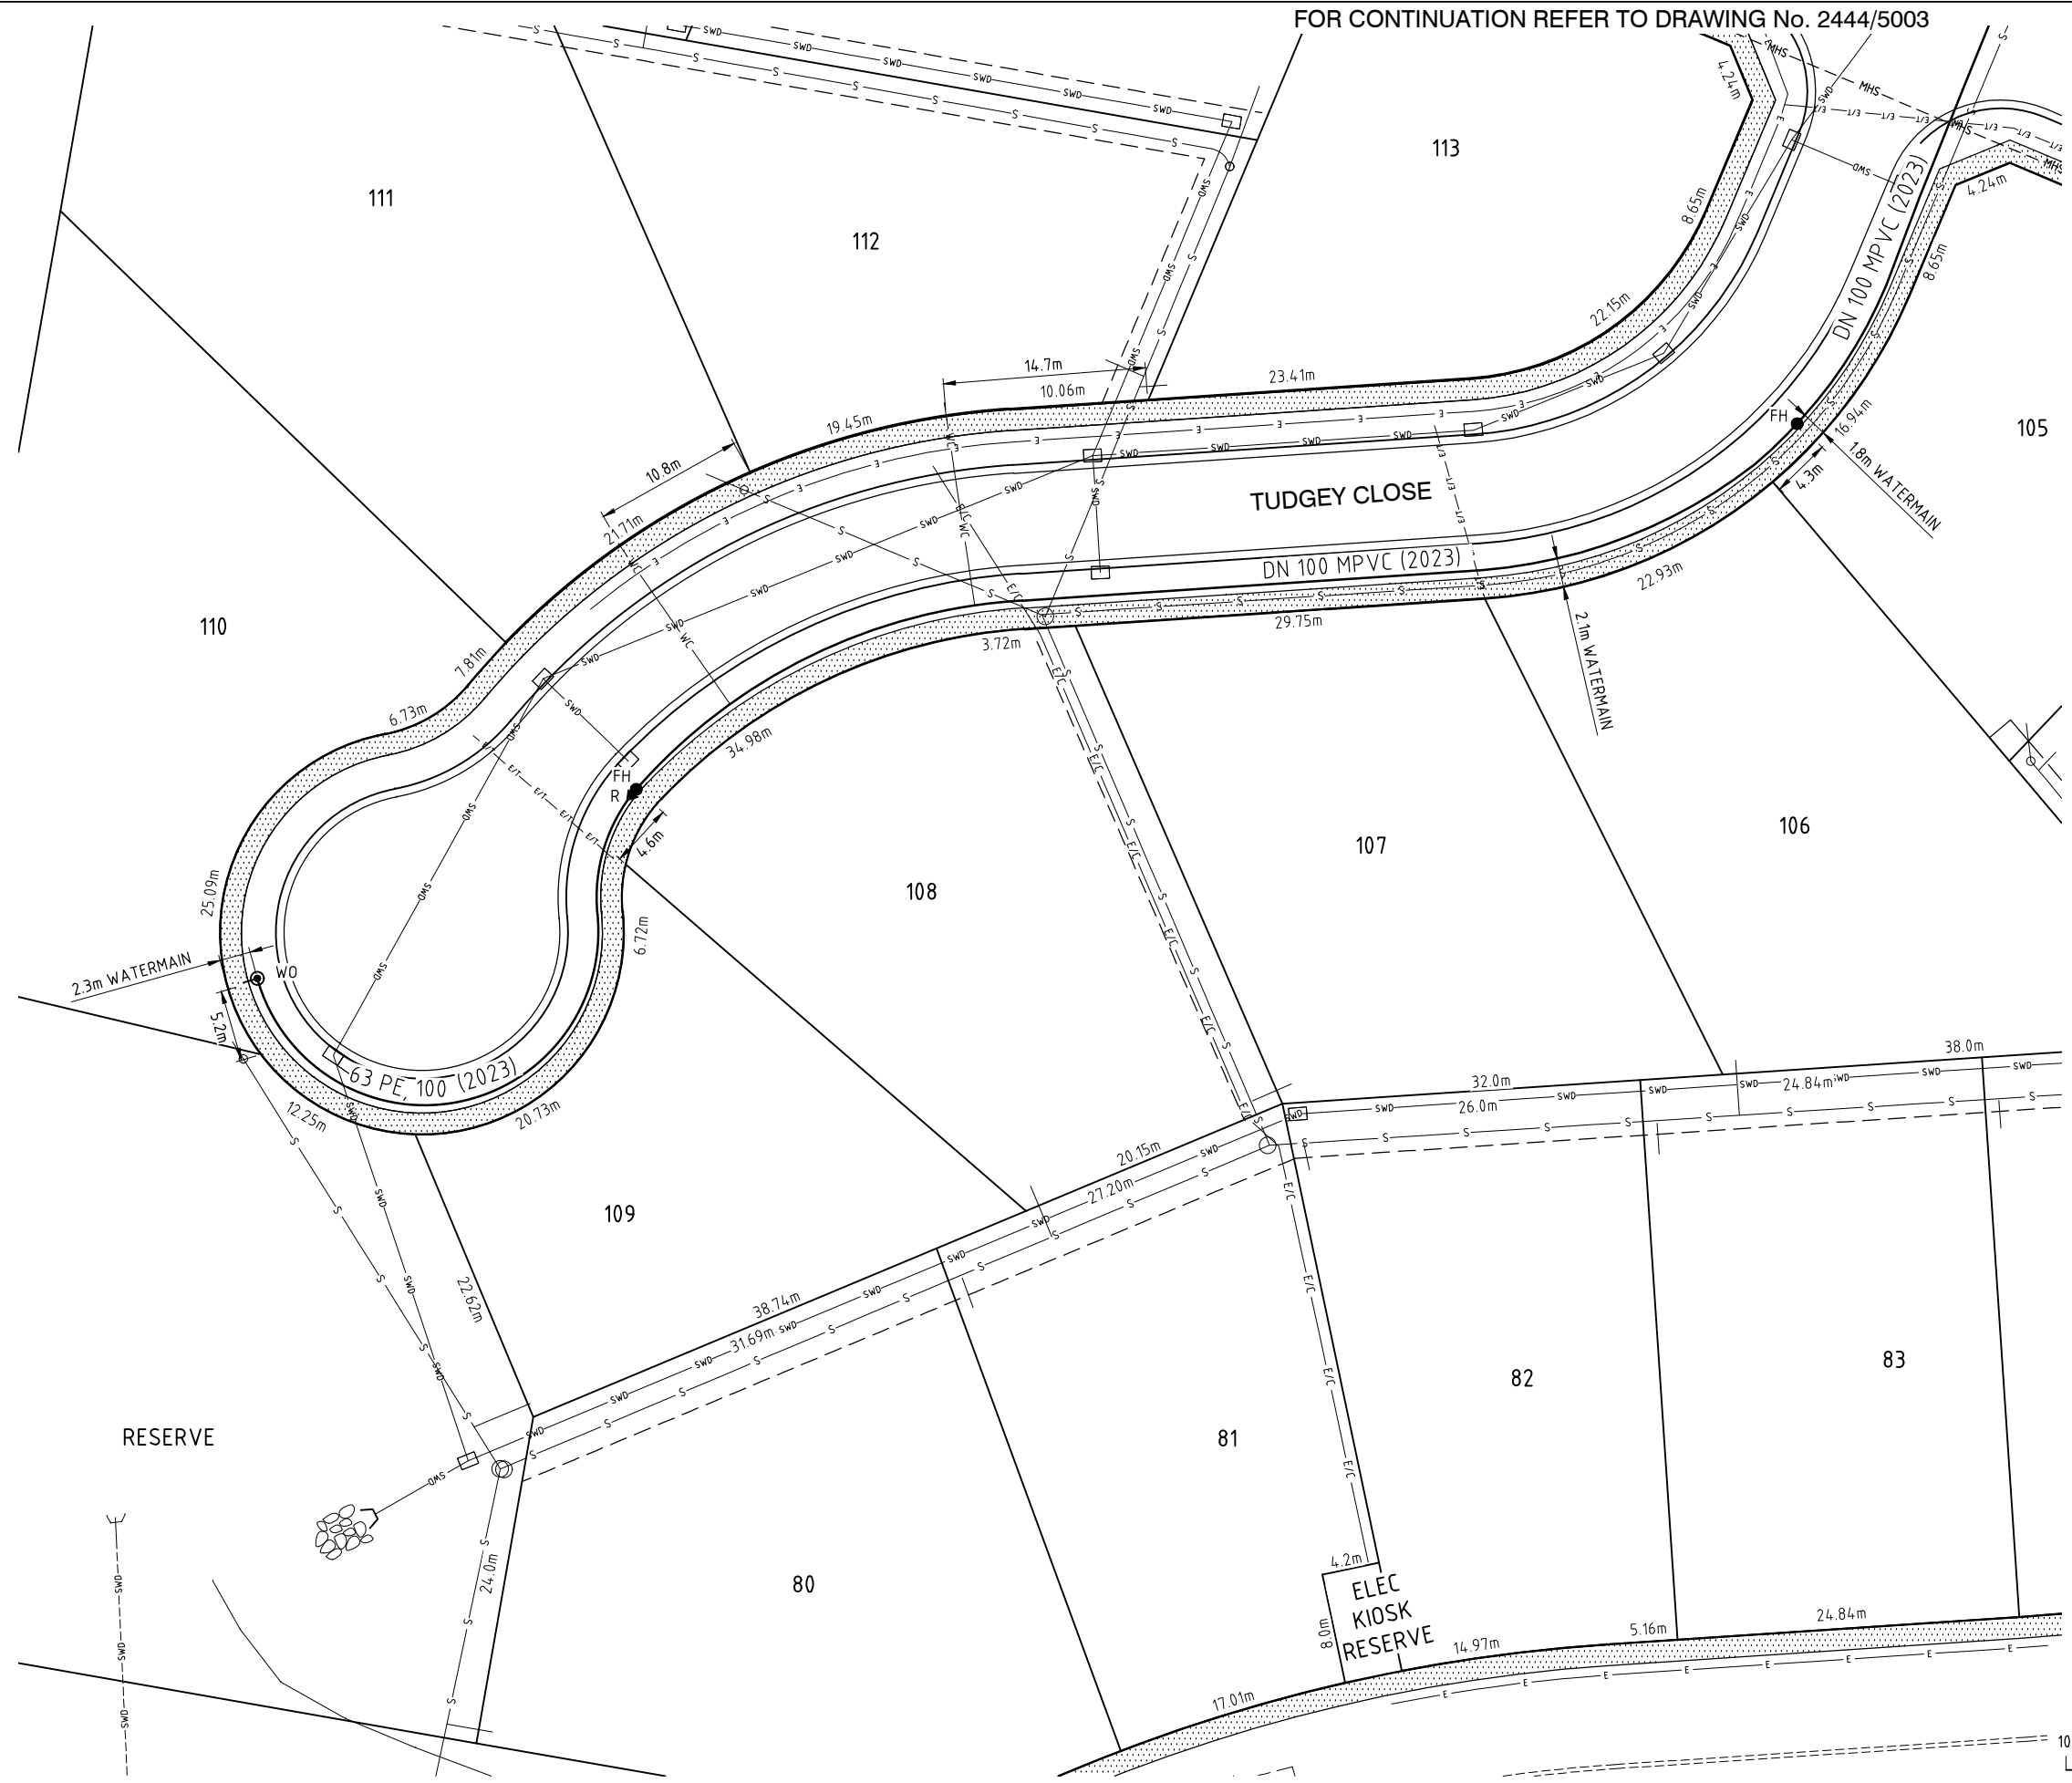


WARNING:
BEWARE OF UNDERGROUND SERVICES
THE LOCATION OF UNDERGROUND SERVICES
ARE APPROXIMATE ONLY AND THEIR EXACT
POSITION SHOULD BE PROVEN ON SITE.
NO GUARANTEE IS GIVEN THAT ALL EXISTING
SERVICES ARE SHOWN.

WARNING:
BEWARE OF LIVE ELECTRICITY.

NOTES:

1. FOR NOTES AND LEGEND REFER TO DRAWING No. 2444/5001

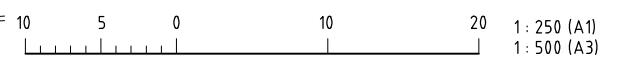

Rv	APPR	DATE	REVISIONS
G	M.S.	15-03-2024	ISSUED TO CLIENT/AGENT
F	M.S.	19-06-2023	AS CONSTRUCTED INFORMATION ADDED
E	A.G.	05-04-2023	ISSUED FOR CONSTRUCTION - UPDATED SEWER ALIGNMENT
D	A.G.	05-12-2022	ISSUED FOR CONSTRUCTION
C	A.G.	22-06-2022	EAST GIPPSLAND WATER AMENDMENTS
B	A.G.	18-05-2022	EAST GIPPSLAND WATER AMENDMENTS
A	A.G.	6-01-2021	ORIGINAL ISSUE

© Crossco Consulting Pty Ltd All Rights Reserved 2022.
Copyright in the whole and every part of this drawing belongs to Crossco Consulting Pty Ltd and may not be used, sold, transferred, copied or reproduced in whole or in part in any manner or form or on any media, to any person other than by agreement with Crossco Consulting Pty Ltd.

This document is produced by Crossco Consulting Pty Ltd solely for the benefit of and use by the client in accordance with the terms of the retainer. Crossco Consulting Pty Ltd does not and shall not assume any responsibility or liability whatsoever to any third party arising out of any use or reliance by third party on the content of this document.

Crossco Consulting Pty Ltd
ABN: 88 135 548 110
154 Macleod St
P.O. Box 858
Bairnsdale Vic 3875
Tel: (03) 51526298
Fax: (03) 51527222
Email: consult@crossco.com.au

DESIGNED: A.G.	A1	DATUM: A.H.D.
DRAWN: A.C.		
CHECKED: A.G.	SURVEY REF: 20210601	
APPROVED: A.G.	PLAN No: PS 845531 E	
SCALE: 1:250		
XREF ATTACHED: R:\2444 Quaystone 120 KCB Metung\ACAD\Xref\2444_BP.dwg		
CAD FILE NAME: R:\2444 Quaystone 120 KCB Metung\ACAD\Drwg\2444-5004.dwg		

METUNG DEVELOPMENTS PTY LTD.
EAST GIPPSLAND WATER
THE WEDGE, KINGS COVE BOULEVARD, METUNG

WATERMAIN
DETAIL LAYOUT PLAN - SHEET 3 OF 3

DATE: MARCH 2022
SHEET 15 OF 17
DRAWING No: **2444/5004**